

STATE ENGINEER
Salem, Oregon

8090 Well Record
MAR 31
MAR 21


STATE WELL NO. 7/3W-25H
COUNTY Marion
APPLICATION NO. GR-4180

J. G. Greenlee and
OWNER: Alice E. Greenlee

MAILING ADDRESS: 1440 Ferry Street
495 Hawthorne Ave
CITY AND STATE: Salem, Oregon

LOCATION OF WELL: Owner's No.
SE 1/4 NE 1/4 Sec. 25 T. 7 N. S., R. 3 E. W., W.M.

Bearing and distance from section or subdivision
corner 65 chains East and 29 chains South
from NW Corner, Savage DLC 79

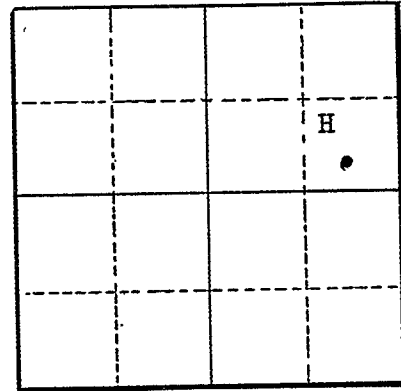

Section 25

Altitude at well gradial slope

TYPE OF WELL: Drilled Date Constructed 1940

Depth drilled 41 feet Depth cased 41 feet

CASING RECORD:

4-inch steel casing set from 0 to 41 feet

FINISH:

No perforations

AQUIFERS:

WATER LEVEL:

15 feet

PUMPING EQUIPMENT: Type F. M. Cent. H.P.
Capacity 15 G.P.M.

WELL TESTS:

Drawdown ft. after hours 200 G.P.M.
Drawdown ft. after hours G.P.M.

USE OF WATER Watering trees and garden Temp. °F., 19

SOURCE OF INFORMATION GR-4077

DRILLER or DIGGER

ADDITIONAL DATA:

Log (NA) Water Level Measurements Chemical Analysis Aquifer Test

REMARKS: