

STATE ENGINEER
Salem, Oregon


8094
MAR

Well Record

STATE WELL NO. 7/3W-26C
COUNTY Marion
APPLICATION NO. GR-4055

OWNER: Frank N. Waters
dba City Ice Works
LOCATION OF WELL: Owner's No. _____
MAILING ADDRESS: 1551 Center St.
CITY AND STATE: Salem, Oregon

NE NW Sec. 26 T. 7 S., R. 3 W., W.M.
Bearing and distance from section or subdivision corner 180' S. 595' W. from N¹/₄ Cor. Sec. 26

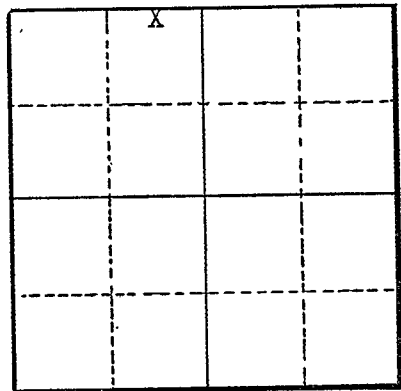

Altitude at well _____
TYPE OF WELL: Drilled Date Constructed 1926
Depth drilled 125 ft. Depth cased 125 ft.

Section 26

CASING RECORD:

8 inch casing set to 125 ft.

FINISH:

Not perforated or screens

AQUIFERS:

WATER LEVEL:

12 feet below surface

PUMPING EQUIPMENT: Type Sterling 5 stage turbine H.P. 10
Capacity 150 G.P.M.

WELL TESTS:

Drawdown _____ ft. after _____ hours _____ G.P.M.
Drawdown _____ ft. after _____ hours _____ G.P.M.

USE OF WATER Industrial cooling Temp. _____ °F. _____, 19____
SOURCE OF INFORMATION Well Registration Statement Cert. # GR-3655

DRILLER or DIGGER

ADDITIONAL DATA:

Log Water Level Measurements _____ Chemical Analysis _____ Aquifer Test _____

REMARKS:

Log: Blue clay at 60 ft. about 4 ft. thick.

75/30-26
Dept. of General

No. 8 Well Tests:

Yield:

<u>Time</u>	<u>Static</u>	<u>GPM</u>	<u>Drawdown</u>
9:00	18'4"		
10:00		20	19'2"
11:00		30	27'0"
11:45		30	30'0"
12:00		35	36'6"
12:15		40	42'2"

RECEIVED

NOV 19 1981

WATER RESOURCES DEPT
SALEM, OREGON

Pump failed and Project Manager decided not to retest.