

STATE ENGINEER
Salem, Oregon

MARI
8111

MARI 8111 Well Record

STATE WELL NO. ² 7/3W-27P(1)
COUNTY Marion
APPLICATION NO. GR-990

GR- 959

OWNER: Henry L. Bahnsen


MAILING ADDRESS: Rt. 5, Box 756

LOCATION OF WELL: Owner's No. _____

CITY AND STATE: Salem, Oregon

SE 1/4 SW 1/4 Sec. 27 T. 7 S, R. 3 W, W.M.

Bearing and distance from section or subdivision
corner 2300' E. & 600' N. from SW cor. Sec 27.

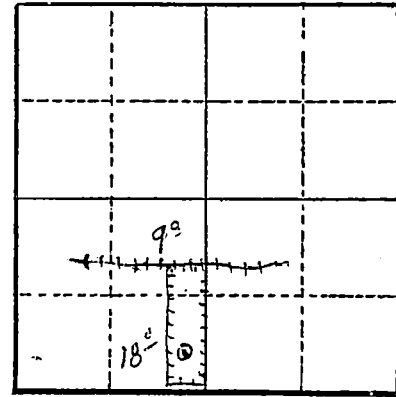

Section 27

Altitude at well 200 ft.

TYPE OF WELL: Drilled Date Constructed 1951

Depth drilled 100 ft. Depth cased 100 ft.

CASING RECORD:

8 inch

FINISH:

Perforations ??

AQUIFERS:

WATER LEVEL:

PUMPING EQUIPMENT: Type Jacuzzi Turbine H.P. 3
Capacity 110 G.P.M.

WELL TESTS:

Drawdown _____ ft. after _____ hours _____ G.P.M.

Drawdown _____ ft. after _____ hours _____ G.P.M.

USE OF WATER Irrigation Temp. _____ °F. _____, 19_____

SOURCE OF INFORMATION G.R. Record

DRILLER or DIGGER _____

ADDITIONAL DATA:

Log _____ Water Level Measurements _____ Chemical Analysis _____ Aquifer Test _____

REMARKS:

Irrigation of 27 acres.