

STATE ENGINEER
Salem, Oregon


Well Record
81522
MAR 21
#1

STATE WELL NO. 7/3W-14L(1)
COUNTY Marion
APPLICATION NO. GR-182

OWNER: James A. Garson MAILING ADDRESS: 2680 Cherry Avenue

LOCATION OF WELL: Owner's No. #1 CITY AND STATE: Salem, Oregon

NE 1/4 SW 1/4 Sec. 14 T. 7 S., R. 3 W., W.M.
Bearing and distance from section or subdivision corner 8.85 chains south and 1.06 chains west from NE corner, SW quarter, Section 14

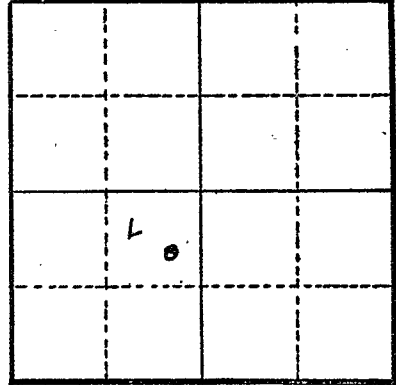

Section 14

Altitude at well 150 feet interpolated

TYPE OF WELL: Drilled Date Constructed Dec. 1954

Depth drilled 70 feet Depth cased 70 feet

CASING RECORD:

6-inch casing from 0 to 70 feet

FINISH:

perforated - 6 holes every 16 inches from 41 1/2 feet to 64 1/2 feet

AQUIFERS:

sand and gravel from 12 to 70 feet (water at 55 to 65 feet)

WATER LEVEL:

26 feet below land surface 1-10-55

PUMPING EQUIPMENT: Type Berkeley Turbine H.P. 3
Capacity 48 G.P.M.

WELL TESTS: Drawdown 46 ft. after pumping 200 hours G.P.M.
Drawdown ft. after hours G.P.M.

USE OF WATER irrigation 3/2 Temp. °F. 19

SOURCE OF INFORMATION GR-169

DRILLER or DIGGER

ADDITIONAL DATA:

Log Water Level Measurements Chemical Analysis Aquifer Test

REMARKS:

Topsoil 0 to 12 12
Sand and gravel 12 to 70 58
(best water between 55 and 65 feet)

