

STATE ENGINEER
Salem, Oregon

8155
MAR Well Record

STATE WELL NO. 7/3M-33H
COUNTY Marion
APPLICATION NO. GR-1533

OWNER: City View Cemetery Association

MAILING ADDRESS:


LOCATION OF WELL: Owner's No.

CITY AND STATE:

Salem, Oregon

SE 1/4 NE 1/4 Sec. 33 T. 7 S., R. 3 W., W.M.

Bearing and distance from section or subdivision corner 390' N. & 95' E. from E1/16 cor. Sec. 33 SW cor. of SE 1/4 NE 1/4

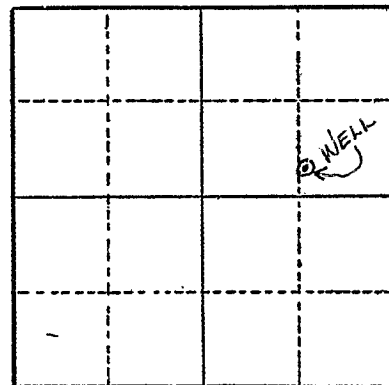

Section 33

Altitude at well 400'

TYPE OF WELL: Drilled Date Constructed 1951

Depth drilled 186' Depth cased 132'

CASING RECORD:

6"

FINISH:

AQUIFERS:

WATER LEVEL:

142'

PUMPING EQUIPMENT: Type Berkeley lineshaft turbine H.P. 15

Capacity 150 G.P.M.

WELL TESTS:

Drawdown 0 ft. after hours 165 G.P.M.

Drawdown ft. after hours G.P.M.

USE OF WATER Irrigation Temp. °F., 19

SOURCE OF INFORMATION GR Record

DRILLER or DIGGER

ADDITIONAL DATA:

Log Water Level Measurements Chemical Analysis Aquifer Test

REMARKS:

Log: Surface clay, red to yellow	0 to 128 ft.
Basalt rock, hard	128 to 137 ft.
Basalt, weathered	137 to 142 ft.
Basalt rock, hard	142 to 146 ft.
Basalt, checked & shattered (water)	146 to 165 ft.
Basalt rock, hard	165 to 178 ft.
Basalt, weathered (water)	178 to 186 ft.

Irrigation of 8.3 acres.