

STATE ENGINEER
Salem, Oregon

3160
MAR 21 1981
Well Record

STATE WELL NO. 7/3W-34J
COUNTY Marion
APPLICATION NO. GR-1837


GR- 1782

OWNER: Max J. Pemberton
MAILING ADDRESS: 1980 S. 12th St.

LOCATION OF WELL: Owner's No. _____
CITY AND STATE: Salem, Oregon

NE 1/4 SE 1/4 Sec. 34 T. 7 S., R. 3 W., W.M.

Bearing and distance from section or subdivision
corner 3100' S. & 5' W. from NE cor. Sec. 34

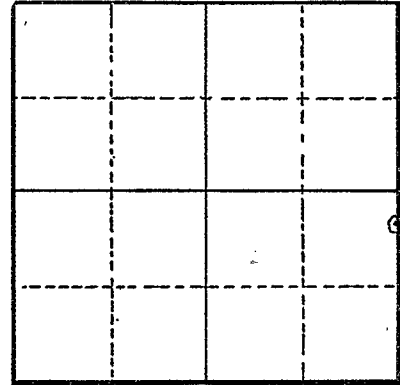

Section 34

Altitude at well _____

TYPE OF WELL: Driven Date Constructed 1925

Depth drilled 22' Depth cased 22'

CASING RECORD:

4"

FINISH:

?

AQUIFERS:

Sand & gravel

WATER LEVEL:

8'

PUMPING EQUIPMENT: Type Goulds jet H.P. 1
Capacity 20 G.P.M.

WELL TESTS:

Drawdown _____ ft. after _____ hours _____ G.P.M.
Drawdown _____ ft. after _____ hours _____ G.P.M.

USE OF WATER Irrigation Temp. _____ °F. _____, 19

SOURCE OF INFORMATION GR Record

DRILLER or DIGGER _____

ADDITIONAL DATA:

Log N.A. Water Level Measurements _____ Chemical Analysis _____ Aquifer Test _____

REMARKS:

Irrigation of 1 acre.