

STATE ENGINEER
Salem, Oregon

8168
MAK

Well Record


STATE WELL NO. 7/3W-35L
COUNTY MARION
APPLICATION NO. GR-2885

OWNER: Harold C. Walling dba Walling Sand and gravel co. MAILING ADDRESS: Salem, Oregon

LOCATION OF WELL: Owner's No. #1 CITY AND STATE:

NE 1/4 SW 1/4 Sec. 35 T. 7 S., R. 3 W., W.M.

Bearing and distance from section or subdivision corner 2100' N., and 2400' E.

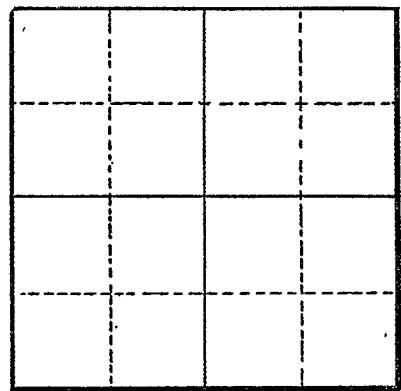

Section

Altitude at well

TYPE OF WELL: drilled Date Constructed 1936

Depth drilled 291 Depth cased 221

CASING RECORD:

12-inch
10-inch

FINISH:

Perforations from 10 to 47

AQUIFERS:

WATER LEVEL:

10-feet

PUMPING EQUIPMENT: Type Sterling H.P. 30
Capacity 600 G.P.M.

WELL TESTS:

Drawdown ft. after hours Pumping 500 G.P.M.
Drawdown ft. after hours G.P.M.

USE OF WATER industrial Temp. °F., 19

SOURCE OF INFORMATION GR-2714

DRILLER or DIGGER Jansen

ADDITIONAL DATA:

Log Water Level Measurements Chemical Analysis Aquifer Test

REMARKS: