

STATE ENGINEER  
Salem, Oregon

2174 8171  
M.R.I. Well Record  
MAK1

STATE WELL NO. 713W-35G  
COUNTY MARION  
APPLICATION NO. GR-3926

OWNER: W. H. Barber


MAILING ADDRESS: 1790 22nd SE

LOCATION OF WELL: Owner's No.

CITY AND STATE: Salem, Oregon

SW 1/4 NE 1/4 Sec. 35 T. 7 S., R. 3 W., W.M.

Bearing and distance from section or subdivision corner 2200' W & 80' N from E 1/4 cor Sec 35

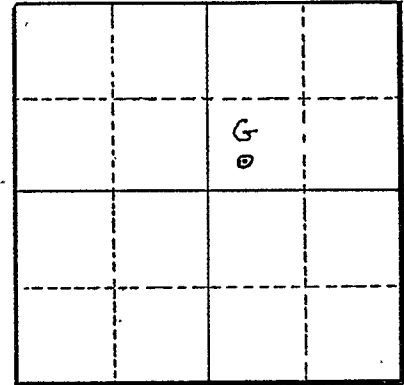

Section 35

Altitude at well

TYPE OF WELL: Drilled Date Constructed 1930

Depth drilled 41' Depth cased

CASING RECORD:

6-inch

FINISH:

AQUIFERS:

WATER LEVEL:

10'

PUMPING EQUIPMENT: Type electric rotary H.P. 3/4  
Capacity 25 G.P.M.

WELL TESTS:  
Drawdown 30 ft. after hours 15 G.P.M.  
Drawdown ft. after hours G.P.M.

USE OF WATER Irrigation Temp. °F., 19

SOURCE OF INFORMATION GR-3944

DRILLER or DIGGER

ADDITIONAL DATA:  
Log NA Water Level Measurements Chemical Analysis Aquifer Test

REMARKS: