

STATE ENGINEER
Salem, Oregon

8173
MARION
8173
MARION

Well Record


STATE WELL NO. 7/3W-35M
COUNTY MARION
APPLICATION NO. GR-2884

OWNER: Harold C. Walling, dba Walling Sand and gravel co. MAILING ADDRESS: Salem, Oregon

LOCATION OF WELL: Owner's No. #2 CITY AND STATE:

NW 1/4 SW 1/4 Sec. 35 T. 7 N. S., R. 3 W., W.M.

Bearing and distance from section or subdivision corner 1500' N. and 1000' E.

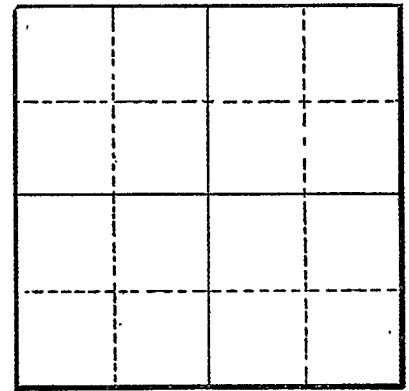

Section

Altitude at well

TYPE OF WELL: drilled Date Constructed 1954

Depth drilled 50 Depth cased 50

CASING RECORD:

8-inch

FINISH:

AQUIFERS:

WATER LEVEL:
10-feet

PUMPING EQUIPMENT: Type Electric H.P. 2
Capacity 25 G.P.M.

WELL TESTS:
Drawdown ft. after hours G.P.M.
Drawdown ft. after hours G.P.M.

USE OF WATER ~~Industrial~~ Industrial Temp. °F., 19
SOURCE OF INFORMATION GR-2713
DRILLER or DIGGER Duffield Bros.

ADDITIONAL DATA:
Log Water Level Measurements Chemical Analysis Aquifer Test

REMARKS: