

STATE ENGINEER
Salem, Oregon

Well Record

STATE WELL NO. 4/1W-29A
COUNTY Marion
APPLICATION NO. GR-1352

GR- 1308

OWNER: George H. McNeal

MAILING
ADDRESS:

Rt. 1, Box 368

LOCATION OF WELL: Owner's No. #1

CITY AND
STATE:

Hubbard, Oregon

NE $\frac{1}{4}$ NE $\frac{1}{4}$ Sec. 29 T. 4 S., R. 1 W., W.M.


Bearing and distance from section or subdivision

corner 500' W. & 800' S. from NE cor. Sec. 29

Altitude at well 180

TYPE OF WELL: Drilled Date Constructed 1952

Depth drilled 100 ft. Depth cased 100 ft.

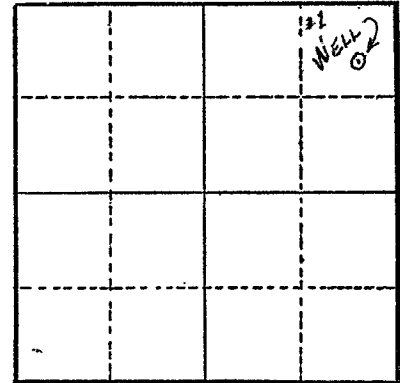

Section 29

CASING RECORD:

6 inch

FINISH:

AQUIFERS:

WATER LEVEL:

32 ft.

PUMPING EQUIPMENT: Type Jet H.P. 1 $\frac{1}{2}$
Capacity 40 G.P.M.

WELL TESTS:

Drawdown 4 ft. after 40 hours G.P.M.

Drawdown ft. after hours G.P.M.

USE OF WATER Irrigation Temp. °F. 19

SOURCE OF INFORMATION G. R. Record

DRILLER or DIGGER Perkins

ADDITIONAL DATA:

Log N.A. Water Level Measurements Chemical Analysis Aquifer Test

REMARKS:

Irrigation of 5 acres.