

STATE ENGINEER
Salem, Oregon

8470
MARI

MARI 8470

Well Record

STATE WELL NO. 7/1-28A(1)
COUNTY Marion
APPLICATION NO. GR-42

OWNER: Willard Benson

MAILING

ADDRESS:

LOCATION OF WELL: Owner's No. #1

CITY AND

STATE: Silverton, Oregon

NE $\frac{1}{4}$ NE $\frac{1}{4}$ Sec. 28 T. 7 N. S. R. 1 E. W.M.

Bearing and distance from section or subdivision


corner 300 yards west and 150 yards south

from NE corner of Section 28

Altitude at well 1350 feet Interpolated

TYPE OF WELL: Drilled Date Constructed Aug. 1952

Depth drilled 188 feet Depth cased 28 feet

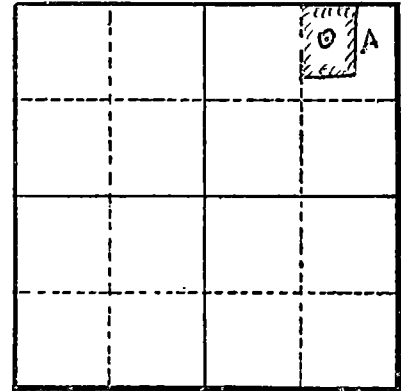

Section 38

CASING RECORD:

8-inch casing set from 0 to 28 feet

FINISH:

none

AQUIFERS:

Basalt, from 157 to 166 feet

WATER LEVEL:

150 feet below land surface August 1952

PUMPING EQUIPMENT: Type submersible H.P. 15
Capacity 200 G.P.M.

WELL TESTS:

Drawdown ft. after hours 96 G.P.M.

Drawdown ft. after hours G.P.M.

USE OF WATER Domestic & Irrigation 22 ac. Temp. °F. 19

SOURCE OF INFORMATION GR-36

DRILLER or DIGGER R. Stadeli and Sons Silverton, Oregon

ADDITIONAL DATA:

Log x Water Level Measurements Chemical Analysis Aquifer Test

REMARKS:

State Well No. 7/1-28A(1)
County Marion
Application No. GR-42

Owner: Willard Benson Owner's No. #1
Driller: R. Stadeli, Silverton, Oregon Date Drilled August 1952

[illegible]