

STATE ENGINEER  
Salem, Oregon

869  
MARI...

# Well Record

STATE WELL NO. 4/1W-30C(1)  
COUNTY Marion  
APPLICATION NO. GR-626

OWNER: Norbert H. Gilles


MAILING ADDRESS: 490 South Pacific Hwy.

LOCATION OF WELL: Owner's No. 1

CITY AND STATE: Woodburn, Oregon

NE 1/4 NW 1/4 Sec. 30 T. 4 N. S. R. 1 E. W., W.M.

Bearing and distance from section or subdivision  
corner 1800' E. & 75' S. from NW cor. Sec. 30

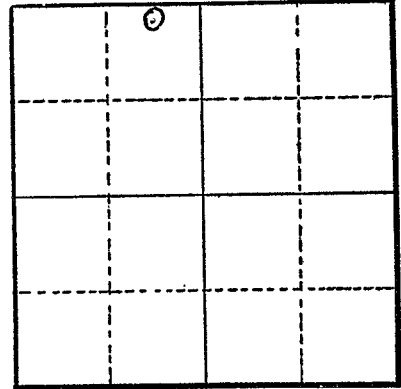

Section 30

Altitude at well 165' Interpolated

TYPE OF WELL: Drilled Date Constructed 5/14/49

Depth drilled 133' Depth cased 133'

### CASING RECORD:

8 inch

### FINISH:

### AQUIFERS:

Sand from 90 to 115

### WATER LEVEL:

8 feet (5- -49)

PUMPING EQUIPMENT: Type Jacuzzi H.P. 30  
Capacity 400 G.P.M.

### WELL TESTS:

Drawdown 80 ft. after 400 hours G.P.M.  
Drawdown ft. after hours G.P.M.

USE OF WATER Irrigation Temp. °F., 19

SOURCE OF INFORMATION 89

DRILLER or DIGGER GR-626

### ADDITIONAL DATA:

Log  Water Level Measurements  Chemical Analysis  Aquifer Test

### REMARKS:

