

* STATE ENGINEER
Salem, Oregon

Well Record

STATE WELL NO. 4/1W-31G
COUNTY Marion
APPLICATION NO. GR-3524

872
MARION

OWNER: Jesse C. Owre

MAILING

ADDRESS: Rt. 1, Box 400


LOCATION OF WELL: Owner's No. _____

CITY AND

STATE: Hubbard, Oregon

SW $\frac{1}{4}$ NE $\frac{1}{4}$ Sec. 31 T. 4 S., R. 1 W., W.M.

Bearing and distance from section or subdivision
corner 825 ft. South and 1350 ft. East from the
NW corner of the Joseph Churchill D.L.C.

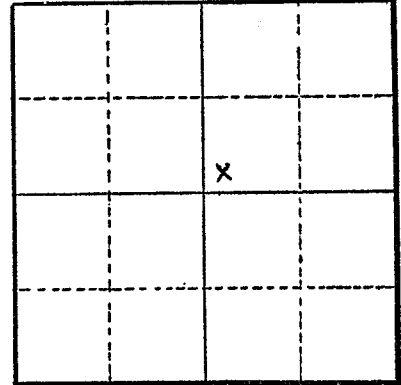

Section 31

Altitude at well _____

TYPE OF WELL: Drilled Date Constructed April, 1951

Depth drilled 140 ft. Depth cased 140 ft.

CASING RECORD:

8 inch set to 140 feet

FINISH:

Torch cut perforations from 127 feet to 140 feet

AQUIFERS:

Sand and gravel

WATER LEVEL:

17 feet below surface

PUMPING EQUIPMENT: Type Western Turbine H.P. 25
Capacity 350 G.P.M.

WELL TESTS:

Drawdown 65 ft. after ? hours 350 G.P.M.
Drawdown 93 ft. after ? hours 650 G.P.M.

USE OF WATER Irrigation Temp. _____ °F., 19____

SOURCE OF INFORMATION Well Registration Statement

DRILLER or DIGGER - - -

ADDITIONAL DATA:

Log X Water Level Measurements _____ Chemical Analysis _____ Aquifer Test _____

REMARKS:

