

STATE ENGINEER  
Salem, Oregon

# Well Record

STATE WELL NO. 4/1W-31D(1)  
COUNTY Marion  
APPLICATION NO. GR-1112

MARI... 882

GR- 1072

OWNER: We, Elgin and Esther Lucas


MAILING ADDRESS: RT. 1

LOCATION OF WELL: Owner's No. \_\_\_\_\_

CITY AND STATE: Hubbard, Oregon

NW 1/4 NW 1/4 Sec. 31 T. 4 S, R. 1 W., W.M.

Bearing and distance from section or subdivision  
corner 180' S. & 1240' E. of NW cor. Sec 31.

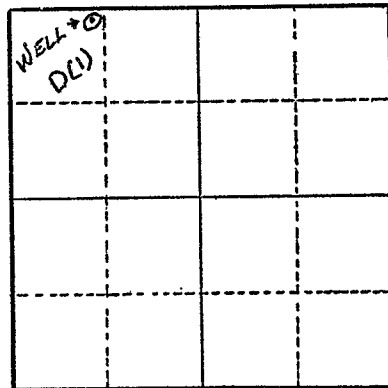

Section 31

Altitude at well 175 ft.

TYPE OF WELL: Drilled Date Constructed 1946

Depth drilled 79 ft. Depth cased 79 ft.

CASING RECORD:

16 inch

FINISH:

AQUIFERS:

WATER LEVEL:

PUMPING EQUIPMENT: Type Pomona turbine H.P. 5  
Capacity 100 G.P.M.

WELL TESTS:

Drawdown \_\_\_\_\_ ft. after \_\_\_\_\_ hours \_\_\_\_\_ G.P.M.  
Drawdown \_\_\_\_\_ ft. after \_\_\_\_\_ hours \_\_\_\_\_ G.P.M.

USE OF WATER Irrigation Temp. \_\_\_\_\_ °F. \_\_\_\_\_, 19\_\_\_\_\_

SOURCE OF INFORMATION G. R. Record

DRILLER or DIGGER Perkins Well Drilling Co.

ADDITIONAL DATA:

Log N.A. Water Level Measurements \_\_\_\_\_ Chemical Analysis \_\_\_\_\_ Aquifer Test \_\_\_\_\_

REMARKS:

Irrigation of 26 acres.