

STATE ENGINEER  
Salem, Oregon

MARI 884

# Well Record


STATE WELL NO. 4/1W-31R  
COUNTY Marion  
APPLICATION NO. GR-914

OWNER: E. C. Hozenen MAILING ADDRESS: Route Box 240

LOCATION OF WELL: Owner's No. CITY AND STATE: Woodburn, Oregon

SE 1/4 SE 1/4 Sec. 31 T. 4 N. S., R. 1 E. W.M.

Bearing and distance from section or subdivision corner 405' N. & 450' W. from SW cor. Sec. 32

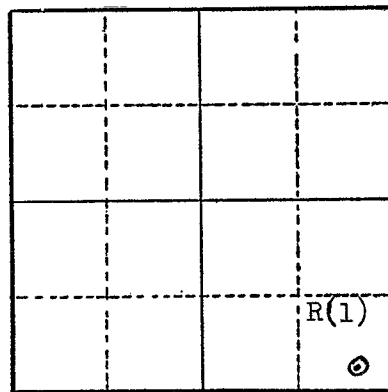

Section 31

Altitude at well 175'

TYPE OF WELL: Drilled Date Constructed Nov. '52

Depth drilled 115 Depth cased 115

### CASING RECORD:

8" steel casing 0 to 115 feet

### FINISH:

Gravel pack 1/2" x 3/4" 75 to 85'  
" " " 90 to 100'

### AQUIFERS:

Sand-Water bearing 33-35  
Gravel water bearing 112-115

### WATER LEVEL:

25'

PUMPING EQUIPMENT: Type Dorward? Jet 1 1/2 discharge H.P. 3 Elec.  
Capacity 50 G.P.M.

### WELL TESTS:

Drawdown 18 ft. after hours 500 G.P.M.  
Drawdown ft. after hours G.P.M.

USE OF WATER Irrigation 32 acres Temp. °F., 19

SOURCE OF INFORMATION Owner

DRILLER or DIGGER Laverne Coleman, Woodburn

### ADDITIONAL DATA:

Log  Water Level Measurements Chemical Analysis Aquifer Test

### REMARKS:

