

STATE ENGINEER
Salem, Oregon

Well Record


STATE WELL NO. 8/1W-260
COUNTY Marion
APPLICATION NO. _____

MI (8068)

OWNER: Edward J. Miotke MAILING ADDRESS: Route 1, Box 29

LOCATION OF WELL: Owner's No. _____ CITY AND STATE: Sublimity

SW $\frac{1}{4}$ SE $\frac{1}{4}$ Sec. 26 T. 8 ^{N.} S., R. 1 ^{E.} W., W.M.
Bearing and distance from section or subdivision corner 350 feet East and 100 feet North from the South $\frac{1}{4}$ corner, Section 26

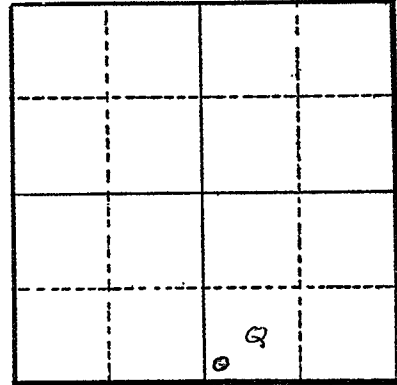

Section 26

Altitude at well 580 feet

TYPE OF WELL: Drilled Date Constructed May, 1951

Depth drilled 380 Depth cased 100

CASING RECORD:

8" steel 0 to 100 feet

FINISH:

open end casing

AQUIFERS:

WATER LEVEL:

77

PUMPING EQUIPMENT: Type Turbine 6" H.P. 20 Elec.
Capacity 600 G.P.M.

WELL TESTS:
Drawdown _____ ft. after _____ hours 500 G.P.M.
Drawdown _____ ft. after _____ hours _____ G.P.M.

USE OF WATER Irrigation Temp. _____ °F. _____, 19____

SOURCE OF INFORMATION owner

DRILLER or DIGGER _____

ADDITIONAL DATA:
Log NA Water Level Measurements _____ Chemical Analysis _____ Aquifer Test _____

REMARKS: