

STATE ENGINEER
Salem, Oregon

(8877)
M 71
Well Record


STATE WELL NO. 8/1W-27J
COUNTY MARION
APPLICATION NO. GR-2351

OWNER: Hilda Schumacher MAILING ADDRESS: _____

LOCATION OF WELL: Owner's No. _____ CITY AND STATE: Sublimity, Oregon

NE 1/4 SE 1/4 Sec. 27 T. 8 S., R. 1 W., W.M.

Bearing and distance from section or subdivision corner 2040' S 58°43' E to SE cor Sec 27

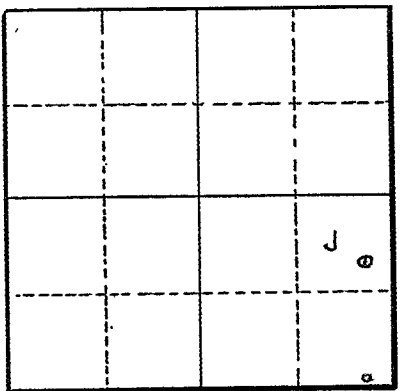

Section 27

Altitude at well _____

TYPE OF WELL: _____ Date Constructed 1953

Depth drilled _____ Depth cased _____

CASING RECORD:

FINISH:

AQUIFERS:

WATER LEVEL:

PUMPING EQUIPMENT: Type Centrifugal H.P. 15
Capacity 150 G.P.M.

WELL TESTS:
Drawdown _____ ft. after _____ hours _____ G.P.M.
Drawdown _____ ft. after _____ hours _____ G.P.M.

USE OF WATER Irrigation Temp. _____ °F. _____, 19____

SOURCE OF INFORMATION GR-3939

DRILLER or DIGGER _____

ADDITIONAL DATA:
Log NA Water Level Measurements _____ Chemical Analysis _____ Aquifer Test _____

REMARKS: