

STATE ENGINEER
Salem, Oregon

8878
M. J. Stadel

Well Record

GR-1721

STATE WELL NO. 8/1W-270
COUNTY Marion
APPLICATION NO. GR-1777

OWNER: Warner C. McCollister


MAILING ADDRESS:

LOCATION OF WELL: Owner's No.

CITY AND STATE: Sublimity, Oregon

SW 1/4 SE 1/4 Sec. 27 T. 8 S. R. 1 W., W.M.

Bearing and distance from section or subdivision corner 500' E. from S¹/₄ cor. Sec. 27

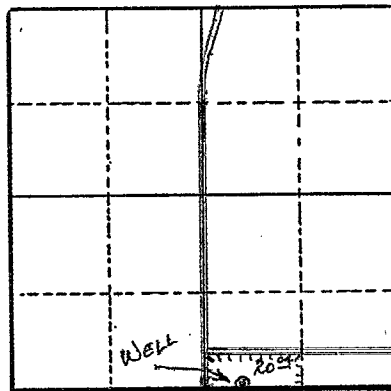

Section 27

Altitude at well 500'

TYPE OF WELL: Drilled Date Constructed 1953

Depth drilled 200' Depth cased 22'

CASING RECORD:

6"

FINISH:

AQUIFERS:

WATER LEVEL:

59'

PUMPING EQUIPMENT: Type Byron Jackson turbine 6" H.P. 10
Capacity 100 G.P.M.

WELL TESTS:

Drawdown 3 ft. after FEB. 1955 hours 90 G.P.M.
Drawdown ft. after hours G.P.M.

USE OF WATER Irrigation Temp. °F. 19

SOURCE OF INFORMATION GR Record

DRILLER or DIGGER R. Stadel & Sons

ADDITIONAL DATA:

Log N.A. Water Level Measurements Chemical Analysis Aquifer Test

REMARKS:

Irrigation of 22.92 acres.