

STATE ENGINEER
Salem, Oregon

9005
MKT...

Well Record

STATE WELL NO. 8/1W-30R(1)
COUNTY Marion
APPLICATION NO. GR-1095

GR-1056

OWNER: Mrs. Edna Elaine Allen


MAILING ADDRESS: Rt. 1, Box 45

LOCATION OF WELL: Owner's No.

CITY AND STATE: Aumsville, Oregon

SE 1/4 SE 1/4 Sec. 30 T. 8 S., R. 1 W., W.M.

Bearing and distance from section or subdivision
corner 940' W. & 720' N. from SE cor. of Sec. 30.

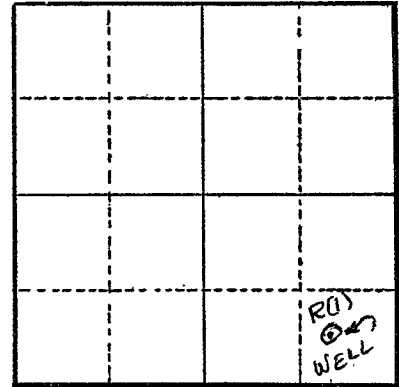

Section 30

Altitude at well 380 ft.

TYPE OF WELL: Drilled Date Constructed 1952

Depth drilled 158 ft. Depth cased 158 ft.

CASING RECORD:

8 inch from 0 to 123 ft.
6 inch from 123 to 158 ft.

FINISH:

Perforated from 35 to 123 ft.

AQUIFERS:

WATER LEVEL:

123 ft.

PUMPING EQUIPMENT: Type Submersible H.P. 1 1/2

Capacity 45 G.P.M.

WELL TESTS:

Drawdown 145 ft. after 45 hours G.P.M.

Drawdown Dry ft. after 50 hours G.P.M.

USE OF WATER Irrigation Temp. °F. 19

SOURCE OF INFORMATION G. R. Record

DRILLER or DIGGER

ADDITIONAL DATA:

Log Water Level Measurements Chemical Analysis Aquifer Test

REMARKS:

Log: Unknown from 0 to 123 ft.
Basalt rock 123 to 156 ft.
Diorite rock (andesite) ? 156 to 158 ft.

Irrigation of 9 acres.