

STATE ENGINEER
Salem, Oregon

9037
M 31... Well Record

STATE WELL NO. 8/1W-31J(1)
COUNTY Marion
APPLICATION NO. GR-230

OWNER: William H. Bankston

MAILING ADDRESS:

LOCATION OF WELL: Owner's No.


CITY AND STATE:

Aumsville, Oregon

SE 1/4 NE 1/4 Sec. 31 T. 8 S, R. 1 W., W.M.

Bearing and distance from section or subdivision

corner North 23° 17' West 58.26 chains from SW corner, Allen J. Davis DLC 66

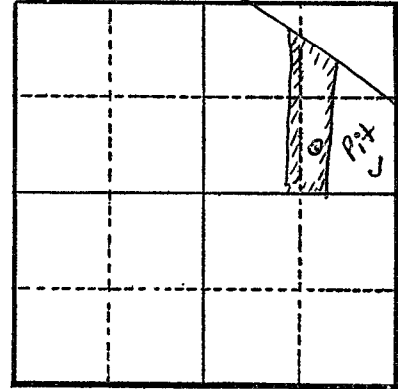

Section 31

Altitude at well 378

TYPE OF WELL: Dug Date Constructed July 1947

Depth drilled 12 Depth cased none

CASING RECORD:

infiltration trench 30 x 40 feet

FINISH:

AQUIFERS:

WATER LEVEL:

6

PUMPING EQUIPMENT: Type Pacific Centrifugal H.P. 12

Capacity 112 + G.P.M.

WELL TESTS:

Drawdown 2 ft. after 6 hours 112 G.P.M.

Drawdown ft. after hours G.P.M.

USE OF WATER Irrigation Temp. °F. 19

SOURCE OF INFORMATION GR-211

DRILLER or DIGGER

ADDITIONAL DATA:

Log no. Water Level Measurements Chemical Analysis Aquifer Test

REMARKS:

Dug by steam shovel