

STATE ENGINEER  
Salem, Oregon

9044  
M 1 31... Well Record

STATE WELL NO. 8/1W-31Q(1)  
COUNTY Marion  
APPLICATION NO. GR-738

OWNER: Bernard F. Winkler


MAILING ADDRESS: Route 1, Box 19

LOCATION OF WELL: Owner's No. 1

CITY AND STATE: Aumsville, Oregon

SW 1/4 SE 1/4 Sec. 31 T. 8 N. S, R. 1 E. W., W.M.

Bearing and distance from section or subdivision  
corner 1649.5 feet North 26° 30' West to the NW  
corner, N. Coffee DLC

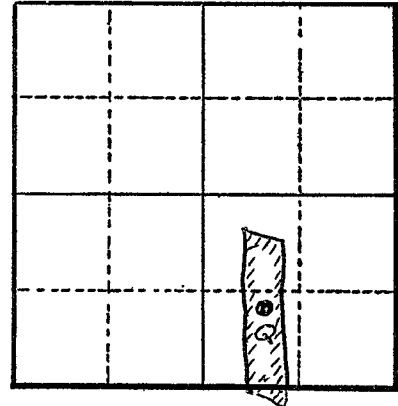

Section 31

Altitude at well 376 feet Interpolated

TYPE OF WELL: Dug Date Constructed 1947

Depth drilled Sump 10' Depth cased none

CASING RECORD:

none

FINISH:

AQUIFERS:

WATER LEVEL:

4.5 to 6 feet

PUMPING EQUIPMENT: Type Wisc. gas - Cent 2 x 2 " H.P. 9  
Capacity G.P.M.

WELL TESTS:

Drawdown 12 ft. after hours 110 G.P.M.  
Drawdown ft. after hours G.P.M.

USE OF WATER Irrigation Temp. °F. 19

SOURCE OF INFORMATION GR-714

DRILLER or DIGGER

ADDITIONAL DATA:

Log none Water Level Measurements Chemical Analysis Aquifer Test

REMARKS: