

STATE ENGINEER  
Salem, Oregon

MARI...5  
905

OBSERVATION WELL  
Well Record


STATE WELL NO. 4/1W-32H(1)  
COUNTY Marion  
APPLICATION NO. GR-100

OWNER: Emmett T. Rose MAILING ADDRESS: Route 1, Box 334

LOCATION OF WELL: Owner's No. CITY AND STATE: Hubbard, Oregon

SE 1/4 NE 1/4 Sec. 32 T. 4 S., R. 1 W., W.M.

Bearing and distance from section or subdivision corner 1650' S. & 1050' W. of NE cor. Sec. 32 T. 4 S., R. 1 W.

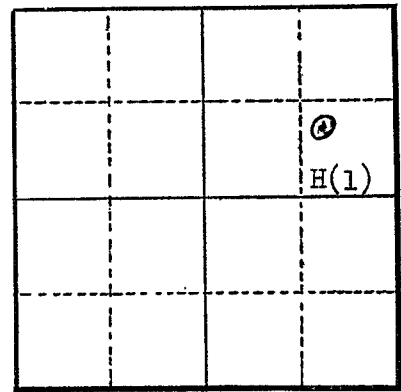

Section 32

Altitude at well 175' Interpolated

TYPE OF WELL: Drilled Date Constructed 4/10/51

Depth drilled 128 Depth cased 128

CASING RECORD:

10 inch steel casing set from 0 to 128 feet

FINISH:

96 perforations 2" x 3/8" set from 122 feet to 128 feet

AQUIFERS:

Black sand and gravel from 94 to 105' and from 120 to 128 feet

WATER LEVEL:

26 feet below land surface August 1951

PUMPING EQUIPMENT: Type Jacuzzi Turbine H.P. 15  
Capacity 175 G.P.M.

WELL TESTS:

Drawdown 40 ft. after 340 hours G.P.M.  
Drawdown ft. after hours G.P.M.

USE OF WATER Irrigation 20 acres Temp. °F., 19

SOURCE OF INFORMATION Registration Statement GR-100

DRILLER or DIGGER Perkins Drilling Company

ADDITIONAL DATA:

Log x Water Level Measurements x Chemical Analysis Aquifer Test

REMARKS:



STATE ENGINEER  
Salem, Oregon


State Well No. 4/W-32 H.O.

County Marion

Application No. GR-100

### Water Level Record

OWNER: Emmett T. Rose OWNER'S NO. #1

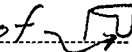Description of measuring point: Top of  cut in casing for Drop lines on east side of well - 0.60 feet above LSD

Date	Water Level Feet (above) (below) Land Surface	Remarks	Date	Water Level Feet (above) (below) Land Surface	Remarks
6/6/60	17.30	WSB (oil on water)			
11-7-60	24.76	WSB			
11-2-61	24.83	WSB & RD			

REMARKS: 15 HP US Motor - Jacuzzi Pump.