

STATE ENGINEER  
Salem, Oregon

9/50  
M131

# Well Record

STATE WELL NO. 8/1W-34R(1)  
COUNTY Marion  
APPLICATION NO. GR-269

OWNER: Alvois Hassler


MAILING ADDRESS: Route 1

LOCATION OF WELL: Owner's No. 1

CITY AND STATE: Sublimity, Oregon

SE 1/4 SE 1/4 Sec. 34 T. 8 S. R. 1 W., W.M.

Bearing and distance from section or subdivision corner 655 feet North and 55 feet West from the SE corner of Section 34

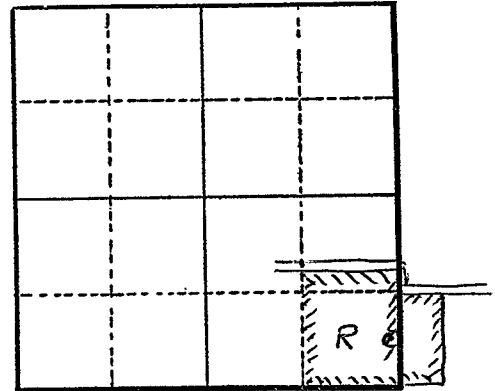

Section 34

Altitude at well 560 feet Interpolated

TYPE OF WELL: Drilled Date Constructed 9-1-43

Depth drilled 230 Depth cased 130

### CASING RECORD:

6-inch casing set from 0 to 130 feet

### FINISH:

open end casing

### AQUIFERS:

unknown

### WATER LEVEL:

65 feet below land surface

PUMPING EQUIPMENT: Type Cook Turbine H.P. 10  
Capacity 120 G.P.M.

### WELL TESTS:

Drawdown none ft. after hours pumping 120 G.P.M.  
Drawdown ft. after hours G.P.M.

USE OF WATER Irrigation 72.5 acres Temp. °F., 19

SOURCE OF INFORMATION GR-249

DRILLER or DIGGER Wymore Bros.

### ADDITIONAL DATA:

Log no Water Level Measurements Chemical Analysis Aquifer Test

### REMARKS: