

STATE ENGINEER
Salem, Oregon

Well Record

STATE WELL NO. 8/1W-34F(1)
COUNTY Marion
APPLICATION NO. GR-225


9/55
13/.....

OWNER: Ray Hartman MAILING ADDRESS:

LOCATION OF WELL: Owner's No. 1 CITY AND STATE: Sublimity, Oregon

SE 1/4 NW 1/4 Sec. 34 T. 8 N. S. R. 1 E. W., W.M.

Bearing and distance from section or subdivision corner 50 feet North and 100 feet West from the center of Section 34

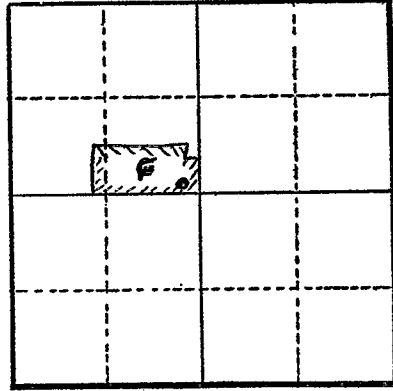

Section 34

Altitude at well 538 feet Interpolated

TYPE OF WELL: Drilled Date Constructed Sept. 1954

Depth drilled 215 Depth cased 85

CASING RECORD:

8 inch casing set from 0 to 85 feet

FINISH:

no record

AQUIFERS:

no record

WATER LEVEL:

57 feet below land surface November 13, 1954

PUMPING EQUIPMENT: Type new pump to be installed soon 10-15 HP H.P.
Capacity 200 G.P.M.

WELL TESTS:

Drawdown 100 ft. after hours pumping 105 G.P.M.
Drawdown 200 ft. after hours " 145 G.P.M.

USE OF WATER Irrigation 18 acres Temp. °F., 19
SOURCE OF INFORMATION GR-208

DRILLER or DIGGER unknown

ADDITIONAL DATA:

Log no. Water Level Measurements Chemical Analysis Aquifer Test

REMARKS: