

STATE ENGINEER  
Salem, Oregon

9195  
MARION

# Well Record

GR- 1307

STATE WELL NO. 8/1W-35E  
COUNTY Marion  
APPLICATION NO. GR- 1351

OWNER: Frank Etzel

MAILING ADDRESS:


LOCATION OF WELL: Owner's No.

CITY AND STATE:

Sublimity, Oregon

SW 1/4 NW 1/4 Sec. 35 T. 8 S., R. 1 W., W.M.

Bearing and distance from section or subdivision corner 42' N. & 126' E. from W 1/4 cor. Sec. 35.

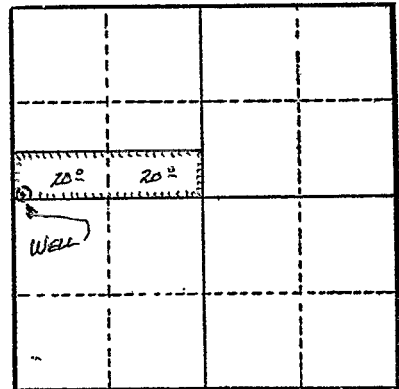

Section 35

Altitude at well 300 ft.

TYPE OF WELL: Drilled Date Constructed 1944

Depth drilled 186 ft. Depth cased 180 ft.

CASING RECORD:

6 inch

FINISH:

AQUIFERS:

WATER LEVEL:

65 ft.

PUMPING EQUIPMENT: Type Turbine H.P. 3  
Capacity 300 G.P.M.

WELL TESTS:

Drawdown ft. after hours G.P.M.  
Drawdown ft. after hours G.P.M.

USE OF WATER Irrigation Temp. °F. 19

SOURCE OF INFORMATION G. R. Record

DRILLER or DIGGER

ADDITIONAL DATA:

Log N.A. Water Level Measurements Chemical Analysis Aquifer Test

REMARKS:

Irrigation of 40 acres.