

STATE ENGINEER
Salem, Oregon

M 9319
MAR 1919

Well Record

STATE WELL NO. 6/1-31G
COUNTY MARION
APPLICATION NO. GR-2627

OWNER: Oscar H. Loe


MAILING ADDRESS: Rt. 1, Box 144,

LOCATION OF WELL: Owner's No. #2

CITY AND STATE: Silverton, Oregon

SW 1/4 NE 1/4 Sec. 31 T. 6 N. S., R. 1 E., W.M.

Bearing and distance from section or subdivision corner S. 56° 40' E. 3065'

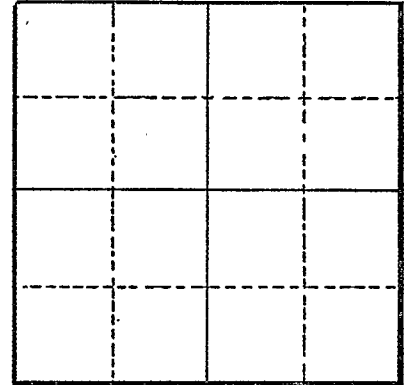

Section

Altitude at well

TYPE OF WELL: Drilled Date Constructed 1950
Depth drilled 301 Depth cased 52

CASING RECORD:

12-inch

FINISH:

AQUIFERS:

Boulders, shale, quartz and rock

WATER LEVEL:

113-feet

PUMPING EQUIPMENT: Type Cornell Turbine H.P. 50
Capacity 600 G.P.M.

WELL TESTS:

Drawdown 48 ft. after hours Pumping 228 G.P.M.
Drawdown 147 ft. after hours Pumping 580 G.P.M.

USE OF WATER Irrigation Temp. °F., 19

SOURCE OF INFORMATION GR-2492

DRILLER or DIGGER Harty Brothers 3115 S.W. Illinois St., Portland 1, Oregon

ADDITIONAL DATA:

Log Water Level Measurements Chemical Analysis Aquifer Test

REMARKS:

Boulders	0	52
Hard blue shale	52	117
Hard gray shale	117	128
Hard blue shale	128	241
Green shale and quartz	241	273
Brown shale	273	275
Black soft rock	275	296
Hard shale and quartz	296	301