

STATE ENGINEER
Salem, Oregon


936-
MARION.....

Well Record

STATE WELL NO. 4/1W-33F(1)
COUNTY Marion
APPLICATION NO. GR-19

OWNER: Mike Bronco MAILING ADDRESS: Route 1
LOCATION OF WELL: Owner's No. #2 CITY AND STATE: Hubbard, Oregon

SE 1/4 NW 1/4 Sec. 33 T. 4 N. S, R. 1 E. W., W.M.
Bearing and distance from section or subdivision corner 140' N. & 720' W. from center of SEC. 33

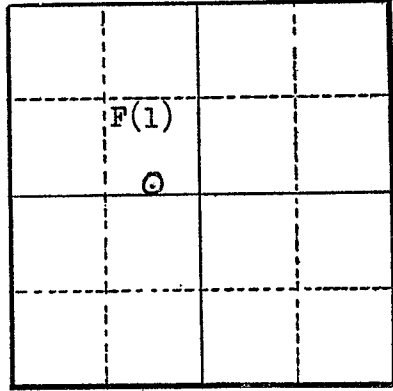

Altitude at well 113' Interpolated

TYPE OF WELL: Drilled Date Constructed March '52

Depth drilled 85' Depth cased 83'

CASING RECORD:

8 inch casing #24.70 set from 0 to 83 feet

FINISH:

Mills perforator 3/8" x 2" with 8 cuts to the row and 8 rows from 76 to 83'

AQUIFERS:

Gravel and black sand from 40 to 83 feet

WATER LEVEL:

Flowing well - 200 gpm with shut in pressure of 15# psi May 1952

PUMPING EQUIPMENT: Type Westinghouse Goulds centrifugal H.P. 15
Capacity 440 G.P.M.

WELL TESTS:

Drawdown none ft. after _____ hours _____ G.P.M.
Drawdown _____ ft. after _____ hours _____ G.P.M.

USE OF WATER Irrigation 55 acres Temp. _____ °F. _____, 19____

SOURCE OF INFORMATION Registration Statement GR-19

DRILLER or DIGGER Perkins Drilling Company

ADDITIONAL DATA:

Log Water Level Measurements Chemical Analysis _____ Aquifer Test _____

REMARKS:

