

STATE ENGINEER
Salem, Oregon

939
MARION

Well Record


STATE WELL NO. 4/1W-33N(1)
COUNTY Marion
APPLICATION NO. GR-19

OWNER: Mike Bronec MAILING ADDRESS: Route 1

LOCATION OF WELL: Owner's No. #3 CITY AND STATE: Hubbard, Oregon

SW 1/4 SW 1/4 Sec. 33 T. 4 N. S., R. 1 E. W., W.M.

Bearing and distance from section or subdivision corner 400' E. and 250' N. from SW cor. Sec. 33

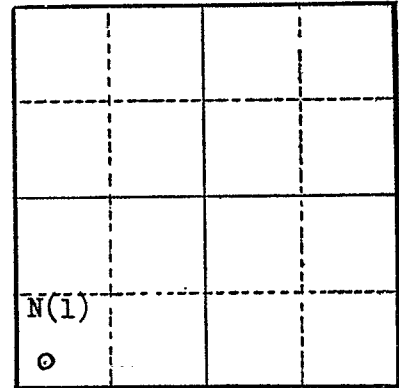

Section 33

Altitude at well 123' Interpolated

TYPE OF WELL: Drilled Date Constructed Apr. '54

Depth drilled 97' Depth cased 97'

CASING RECORD:

8 inch casing set from 0 to 97 feet.

FINISH:

Casing perforated from 90 to 97 feet

AQUIFERS:

Gravel, from 90 to 97 feet

WATER LEVEL:

Flowing well 130 gpm April, 1954

PUMPING EQUIPMENT: Type Centrifugal pump 0-2 tractor motor H.P.
Capacity 240 G.P.M.

WELL TESTS:	31		392	
Drawdown	27	ft. after	323	G.P.M.
Drawdown	21	ft. after	244	G.P.M.
Drawdown	14	ft. after	200	G.P.M.

USE OF WATER Irrigation 29 acres Temp. °F. , 19

SOURCE OF INFORMATION Registration Statement GR-19

DRILLER or DIGGER

ADDITIONAL DATA:

Log X Water Level Measurements Chemical Analysis Aquifer Test

REMARKS:

Flows in winter.

