

STATE ENGINEER
Salem, Oregon

M 9614
MAR 21.....

Well Record


STATE WELL NO. 8/2W-6db
COUNTY Marion
APPLICATION NO. GR-308

OWNER: J. S. Beck
MAILING ADDRESS: 2875 South Lancaster Drive

LOCATION OF WELL: Owner's No. 1
CITY AND STATE: Salem, Oregon

NW 1/4 SE 1/4 Sec. 6 T. 8 S., R. 2 W., W.M.

Bearing and distance from section or subdivision
corner South 51 chains and West 22 chains from
the NE Corner of Section 6

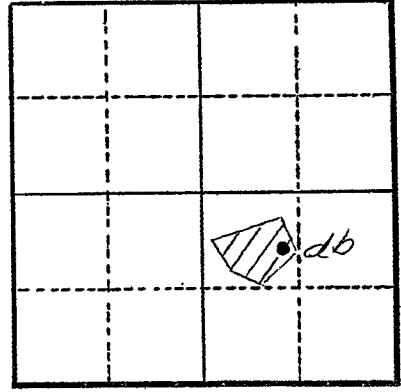

Section 6

Altitude at well 230 feet Interpolated

TYPE OF WELL: Drilled Date Constructed 4-20-50

Depth drilled 115 feet Depth cased 115 feet

CASING RECORD:
9/2-inch standard casing set from 0 to 115 feet

FINISH:
unknown sizes - perforated between
38 - 40 feet
46 - 50 feet
63 - 65 feet
70 - 98 feet
103 - 113 feet

AQUIFERS:
sand and gravel from 29 feet to 115 feet

WATER LEVEL:
8 feet below land surface

PUMPING EQUIPMENT: Type Fairbanks - Morse - Turbine 3" H.P. 7 1/2
Capacity 130 G.P.M.

WELL TESTS:
Drawdown 109 ft. after hours pumping 125 G.P.M.
Drawdown ft. after hours G.P.M.

USE OF WATER Irrigation 12 acres Temp. °F., 19

SOURCE OF INFORMATION GR-287
DRILLER or DIGGER Duffield Bros., Route 9, Box 58, Salem, Oregon

ADDITIONAL DATA:
Log Yes Water Level Measurements Chemical Analysis Aquifer Test

REMARKS: