

STATE ENGINEER  
Salem, Oregon

MAILED  
9668  
Well Record

STATE WELL NO. 82w-7J(1)  
COUNTY Marion  
APPLICATION NO. GR-693

OWNER: Oregon State Hospital


MAILING ADDRESS: Station A.

LOCATION OF WELL: Owner's No. #1

CITY AND STATE: Salem, Oregon

NE 1/4 SE 1/4 Sec. 7 T. 8 S., R. 2 W., W.M.

Bearing and distance from section or subdivision  
corner 3759' S. & 1093' W. of NE corner  
section 7.

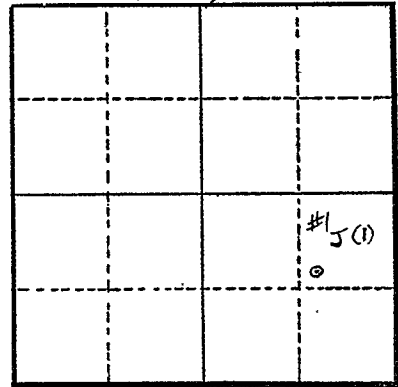

Section 7

Altitude at well 230.15 feet

TYPE OF WELL: Drilled Date Constructed 1937

Depth drilled 110 ft. Depth cased 110 ft.

CASING RECORD:  
10 in. from 0 to 110 feet

FINISH:

AQUIFERS:

WATER LEVEL:  
11 feet

PUMPING EQUIPMENT: Type U.S. type CFU - Deming turbine 4 in. H.P. 15  
Capacity 150 G.P.M.

WELL TESTS:  
Drawdown ..... ft. after ..... hours ..... G.P.M.  
Drawdown ..... ft. after ..... hours ..... G.P.M.

USE OF WATER Irrigation Temp. ..... °F. ...., 19.....

SOURCE OF INFORMATION GR- 693  
DRILLER or DIGGER R.J. Strasser Drilling Co. Portland

ADDITIONAL DATA:  
Log ..... Water Level Measurements ..... Chemical Analysis ..... Aquifer Test .....

REMARKS: