

STATE ENGINEER  
Salem, Oregon

MAR 1947

# Well Record

STATE WELL NO. 4/1W-34D(1)  
COUNTY Marion  
APPLICATION NO. GR-1084

GR- 1045

OWNER: Roy L. Mortensen

MAILING ADDRESS: Box 15


LOCATION OF WELL: Owner's No.

CITY AND STATE: Hubbard, Oregon

NW 1/4 NW 1/4 Sec. 34 T. 4 S. R. 1 W., W.M.

Bearing and distance from section or subdivision

corner 450' E. & 150' S. from NW cor. Sec. 34.

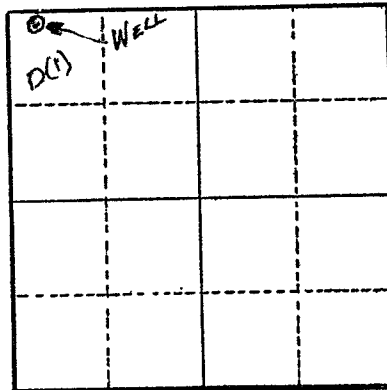

Section 34

Altitude at well

TYPE OF WELL: Drilled Date Constructed 1946

Depth drilled 217 ft. Depth cased 217 ft.

### CASING RECORD:

6 inch

### FINISH:

### AQUIFERS:

### WATER LEVEL:

70 ft.

PUMPING EQUIPMENT: Type Cook turbine H.P. 5

Capacity 75 G.P.M.

### WELL TESTS:

Drawdown 70 ft. after 100 hours G.P.M.

Drawdown ft. after hours G.P.M.

USE OF WATER Irrigation Temp. °F., 19

SOURCE OF INFORMATION G.R. Record

DRILLER or DIGGER J. T. Miller

### ADDITIONAL DATA:

Log N.A. Water Level Measurements Chemical Analysis Aquifer Test

### REMARKS:

Irrigation of 10 acres.