

STATE ENGINEER  
Salem, Oregon

MARI...989

# Well Record

STATE WELL NO. 4/1W-34J  
COUNTY Marion  
APPLICATION NO. GR-3995

OWNER: Orlando G. Arnold


MAILING ADDRESS: Route 1, Box 240 Pg 1 of 2

LOCATION OF WELL: Owner's No.

CITY AND STATE: Hubbard, Oregon

NE 1/4 SE 1/4 Sec. 34 T. 4 S. R. 1 W., W.M.

Bearing and distance from section or subdivision  
corner 1690' E. & 250' S. from center of Sec. 34

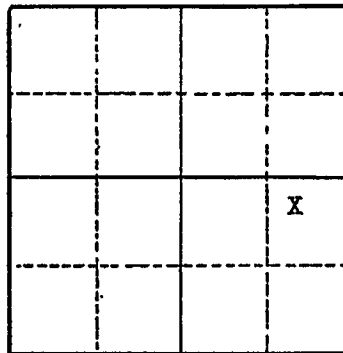

Section 34

Altitude at well

TYPE OF WELL: Drilled Date Constructed Aug., 1954

Depth drilled 68 ft. Depth cased 66 ft.

### CASING RECORD:

6 inch steel casing set to 66 feet

### FINISH:

perforations from 58 to 66 feet

### AQUIFERS:

### WATER LEVEL:

30 feet below surface

PUMPING EQUIPMENT: Type Jet pump H.P. 1 1/2  
Capacity 25 G.P.M.

### WELL TESTS:

Drawdown ft. after hours G.P.M.  
Drawdown ft. after hours G.P.M.

USE OF WATER Irrigation Temp. °F, 19

SOURCE OF INFORMATION Well Registration Statement Cert. # GR-3602

DRILLER or DIGGER J. T. Miller

### ADDITIONAL DATA:

Log  Water Level Measurements  Chemical Analysis  Aquifer Test

### REMARKS:

Log:

- 0 to 6 Surface
- 6 to 54 Sandy clay
- 54 to 63 Broken clay
- 63 to 64 Tough blue clay
- 64 to 68 Gravel

STATE ENGINEER  
Salem, Oregon

MARI 989

# Well Record

STATE WELL NO. 4/1W-34J(1)  
COUNTY Marion  
APPLICATION NO.

OWNER: O. G. Arnold


MAILING ADDRESS: Pg 2 of 2

LOCATION OF WELL: Owner's No.

CITY AND STATE:

1/4 1/4 Sec. T. N. E. S, R. W., W.M.

Bearing and distance from section or subdivision corner

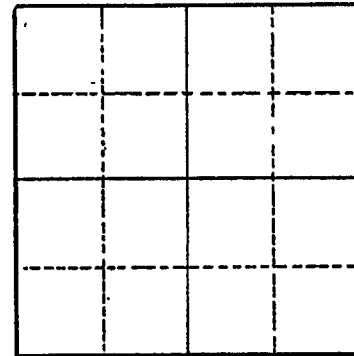

Section

Altitude at well 170

TYPE OF WELL: Drilled Date Constructed 1954

Depth drilled 68 Depth cased 66

### CASING RECORD:

6 inch

### FINISH:

Open bottom, casing unperforated

### AQUIFERS:

Gravel from 64 to 68

### WATER LEVEL:

30 feet

PUMPING EQUIPMENT: Type Jet H.P. 1 1/2  
Capacity G.P.M.

### WELL TESTS:

Drawdown ft. after hours G.P.M.

Drawdown ft. after hours G.P.M.

USE OF WATER Domestic, Irrigation-1 1/2 ac Temp. °F. 19

SOURCE OF INFORMATION USGS

DRILLER or DIGGER

### ADDITIONAL DATA:

Log Water Level Measurements Chemical Analysis Aquifer Test

### REMARKS: