

RECEIVED JUN 15 1960

MARI... 9910

8/2w-11A

File Original and First Copy with the STATE ENGINEER, SALEM, OREGON

STATE ENGINEER WATER WELL REPORT SALEM, OREGON STATE OF OREGON

State Well No. State Permit No.

(1) OWNER: Name Lloyd M. Hill Inc. Address RT 5 Box 751H Salem 10th

(2) LOCATION OF WELL: County MARION Owner's number, if any - 1/4 Section T. R. W.M. Bearing and distance from section or subdivision corner see attached sheet

(3) TYPE OF WORK (check): New Well [x] Deepening [] Reconditioning [] Abandon [] If abandonment, describe material and procedure in Item 11.

(4) PROPOSED USE (check): Domestic [] Industrial [] Municipal [] Irrigation [x] Test Well [] Other [] (5) TYPE OF WELL: Rotary [] Driven [] Cable [x] Jetted [] Dug [] Bored []

(6) CASING INSTALLED: Threaded [] Welded [x] 8" Diam. from 1 ft. to 37 ft. Gage STD.

(7) PERFORATIONS: Perforated? [] Yes [x] No [] Type of perforator used SIZE of perforations in. by in. perforations from ft. to ft.

(8) SCREENS: Well screen installed [] Yes [x] No [] Manufacturer's Name Type Model No. Slot size Set from ft. to ft.

(9) CONSTRUCTION: Was well gravel packed? [] Yes [x] No [] Size of gravel: Gravel placed from ft. to ft. Was a surface seal provided? [x] Yes [] No [] To what depth? 11 ft. Material used in seal- Did any strata contain unusable water? [] Yes [x] No [] Type of water? Depth of strata Method of sealing strata off

(10) WATER LEVELS: 4 FT. ABOVE SURFACE Static level ft. below land surface Date APRIL 15 Artesian pressure lbs. per square inch Date

Log Accepted by: Lloyd M. Hill Inc. (Signed) Date 1960

(11) WELL TESTS: Drawdown is amount water level is lowered below static level Was a pump test made? [x] Yes [] No If yes, by whom? STETTLER Yield: 120 gal./min. with 47 ft. drawdown after 2 1/2 hrs.

(12) WELL LOG: Diameter of well 8 inches. Depth drilled 62 ft. Depth of completed well 62 ft. Formation: Describe by color, character, size of material and structure, and show thickness of aquifers and the kind and nature of the material in each stratum penetrated, with at least one entry for each change of formation.

Table with columns: MATERIAL, FROM, TO. Entries: SHALE - YELLOW (1-21), BROWN (21-33), BLACK (33-37), BROWN (37-55), SAND STONE (55-62)

Work started MARCH 7 1960 Completed MARCH 15 1960

(13) PUMP: Manufacturer's Name Type: H.P.

Well Driller's Statement: This well was drilled under my jurisdiction and this report is true to the best of my knowledge and belief.


NAME H. P. MILLER (Person, firm, or corporation) (Type or print) Address RT 5 - Box 112A Driller's well number [Signed] Hamilton R. Miller (Well Driller) License No. 311 Date APRIL 15 1960

Lloyd M. Hill

S/2w-11A
Marion

RECEIVED
JUN 15 1960
STATE ENGINEER
SALMON, OREGON

Salem 5 miles

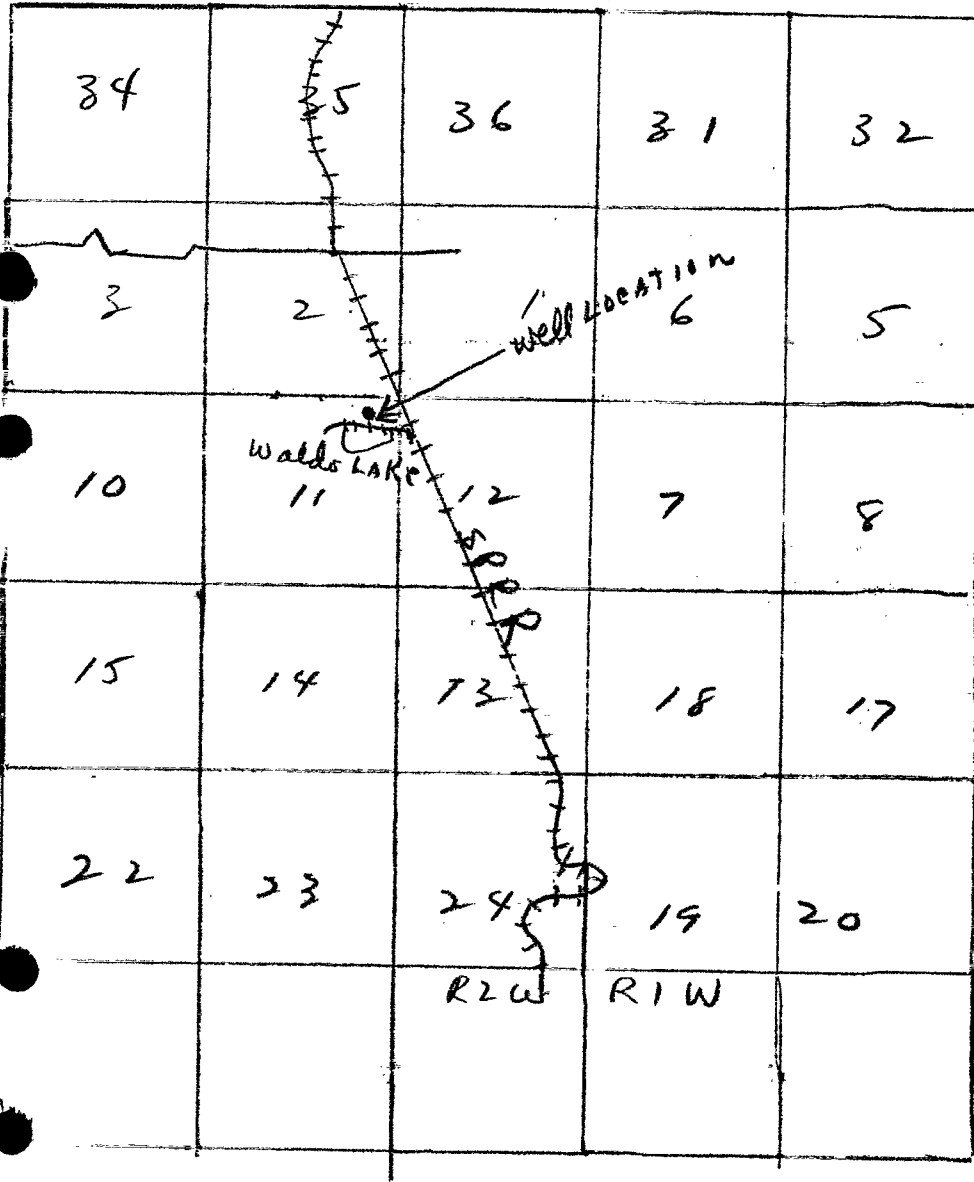

T.7.S.
T.8.S.