

STATE ENGINEER
Salem, Oregon

MARI 992

Well Record

STATE WELL NO. 4/1W-34M
COUNTY MARION
REGISTRATION NO. GR-3847

OWNER: Duane Warye

MAILING ADDRESS:

Rt 1 Box 273

Pg 1 of 2


LOCATION OF WELL: Owner's No. _____

CITY AND STATE:

Hubbard, Oregon

NW 1/4 SW 1/4 Sec. 34 T. 4 S., R. 1 W., W.M.

Bearing and distance from section or subdivision corner S 86°15' W 825 ch from NE cor of donation land claim of Eric Purvine

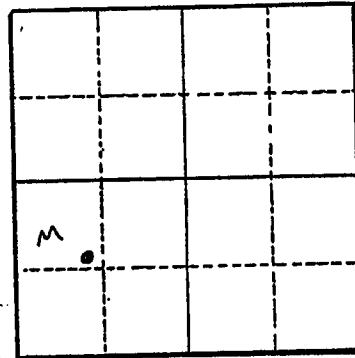

Section 34

Altitude at well _____

TYPE OF WELL: Drilled Date Constructed 1950

Depth drilled 130' Depth cased 130'

CASING RECORD:

6-inch

FINISH:

AQUIFERS:

WATER LEVEL:

50'

PUMPING EQUIPMENT: Type Jacuzzi

H.P. 2

Capacity 40 G.P.M.

WELL TESTS:

Drawdown _____ ft. after _____ hours _____ G.P.M.

Drawdown _____ ft. after _____ hours _____ G.P.M.

USE OF WATER Irrigation Temp. _____ °F. _____, 19_____

SOURCE OF INFORMATION GR-3958

DRILLER or DIGGER _____

ADDITIONAL DATA:

Log NA Water Level Measurements _____ Chemical Analysis _____ Aquifer Test _____

REMARKS:

STATE ENGINEER
Salem, Oregon

992
MAR. 72

Well Record

STATE WELL NO. 4/1W-34M(2)
COUNTY Marion
APPLICATION NO.

OWNER: Duane Warya

MAILING ADDRESS: Pg 2 of 2

LOCATION OF WELL: Owner's No.

CITY AND STATE:

..... ¼ ¼ Sec. T. N. E. S., R. W., W.M.

Bearing and distance from section or subdivision corner

Altitude at well 175

TYPE OF WELL: Drilled Date Constructed 1950

Depth drilled 130 Depth cased

Section

CASING RECORD:

6 inch

FINISH:

AQUIFERS:

WATER LEVEL:

50 feet

PUMPING EQUIPMENT: Type Jet H.P. 2
Capacity G.P.M.

WELL TESTS:

Drawdown ft. after hours G.P.M.

Drawdown ft. after hours G.P.M.

USE OF WATER Domestic, Irrigation-4 ac. Temp. °F. 19

SOURCE OF INFORMATION USGS

DRILLER or DIGGER

ADDITIONAL DATA:

Log Water Level Measurements Chemical Analysis Aquifer Test

REMARKS: