

STATE ENGINEER
Salem, Oregon

MARI. 993

Well Record

GR- 1788

STATE WELL NO. 4/1W-34M
COUNTY Marion
APPLICATION NO. GR- 1843

OWNER: George & Lottie Robb


MAILING ADDRESS: Rt. 1, Box 272

LOCATION OF WELL: Owner's No. #1

CITY AND STATE: Hubbard, Oregon

NW 1/4 SW 1/4 Sec. 34 T. 4 S., R. 1 W., W.M.

Bearing and distance from section or subdivision
corner 1210' E. & 1610' N. from SW cor. Sec. 34

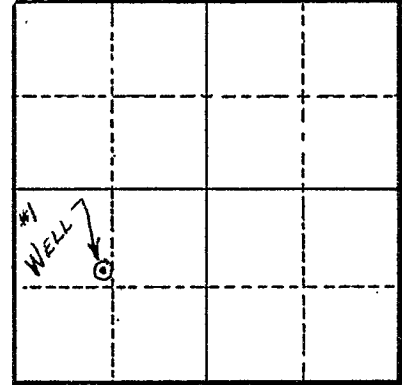

Section 34

Altitude at well 178

TYPE OF WELL: Drilled Date Constructed 1948

Depth drilled 120' Depth cased 120'

CASING RECORD:

8"

FINISH:

Perforated: 6/ft./row - 3 rows - 3/8" x 1 1/2" slots from 108 to 118 ft.

AQUIFERS:

WATER LEVEL:

19'

PUMPING EQUIPMENT: Type Turbine H.P. 2
Capacity 80 G.P.M.

WELL TESTS:

Drawdown 36' ft. after hours 75 G.P.M.
Drawdown 73' ft. after hours 105 G.P.M.

USE OF WATER Irrigation - 5 acres Temp. °F. 19

SOURCE OF INFORMATION GR Record

DRILLER or DIGGER John Beck

ADDITIONAL DATA:

Log Water Level Measurements Chemical Analysis Aquifer Test

REMARKS:

Log: Top soil & brown silt 0 to 23 ft.
Blue silt 23 to 47 ft.
Blue clay, dark 47 to 97 ft.
Fine sand, dark 97 to 104 ft.
Sand & gravel 104 to 115 ft.
Gravel, very little sand 115 to 119 ft.
Greenish blue clay 119 to 120 ft.

Irrigation of 5 acres.