

STATE ENGINEER
Salem, Oregon

996
M 121.....

Well Record

STATE WELL NO. 4/LW-34M
COUNTY Marion
APPLICATION NO. GR-3859

OWNER: Allen & Elizabeth Schlabach

MAILING ADDRESS: Route 1, Box 200 A

LOCATION OF WELL: Owner's No. _____

CITY AND STATE: Hubbard, Oregon

pg 1 of 2

NW ¼ SW ¼ Sec. 34 T. 4 S., R. 1 W., W.M.


Bearing and distance from section or subdivision

corner 240' N. & 145' W. of SE cor. of NW ¼ SW ¼
Sec. 34

Altitude at well _____

TYPE OF WELL: drilled Date Constructed Mar., 1955

Depth drilled 114 ft. Depth cased: 114 feet

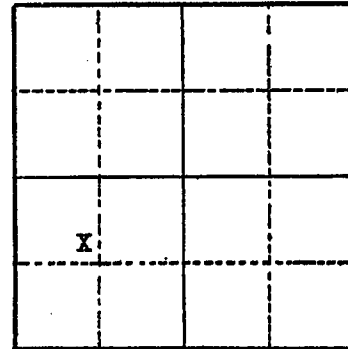

Section 34

CASING RECORD:

6 inch steel casing set to 114 feet

FINISH:

AQUIFERS:

WATER LEVEL:

14.5 feet below surface

PUMPING EQUIPMENT: Type Jacuzzi

H.P. 3

Capacity 30 G.P.M.

WELL TESTS:

Drawdown 60 ft. after _____ hours 45 G.P.M.

Drawdown _____ ft. after _____ hours _____ G.P.M.

USE OF WATER Irrigation Temp. _____ °F., 19.

SOURCE OF INFORMATION Well Registration Statement Cert. # GR-3515

DRILLER or DIGGER _____

ADDITIONAL DATA:

Log X Water Level Measurements _____ Chemical Analysis _____ Aquifer Test _____

REMARKS:

Log	Thickness	Depth to Bottom
Dug well	0	20
Sand	20	31
Dirty sandy clay	31	88
Gray sand with some water	88	102
Sand and gravel	102	114

STATE ENGINEER
Salem, Oregon

MARI...996

Well Record

STATE WELL NO. 4/1W-34N(1)
COUNTY Marion
APPLICATION NO.

OWNER: Allen Schlaback

MAILING ADDRESS:


LOCATION OF WELL: Owner's No.

CITY AND STATE:

pg 2 of 2

1/4 1/4 Sec. T. N. S., R. E. W., W.M.

Bearing and distance from section or subdivision corner

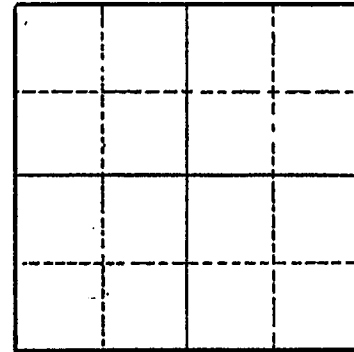

Altitude at well 175

TYPE OF WELL: Drilled Date Constructed 1955

Depth drilled 114 Depth cased

Section

CASING RECORD:

6 inch

FINISH:

AQUIFERS:

Sand and gravel from 102 to 114

WATER LEVEL:

14 feet below land surface, April, 1955

PUMPING EQUIPMENT: Type Jet Capacity G.P.M. H.P. 3

WELL TESTS:

Drawdown ft. after hours G.P.M.

Drawdown ft. after hours G.P.M.

USE OF WATER Domestic, Irr.-2 1/2 acres Temp. °F. 19

SOURCE OF INFORMATION USGS

DRILLER or DIGGER

ADDITIONAL DATA:

Log Water Level Measurements Chemical Analysis Aquifer Test

REMARKS: