

STATE ENGINEER  
Salem, Oregon

MARK 189

# Well Record

STATE WELL NO. 2/27-31R  
COUNTY Morrow  
APPLICATION NO. G-1089

OWNER: City of Heppner MAILING ADDRESS: \_\_\_\_\_

LOCATION OF WELL: Owner's No. 3 CITY AND STATE: Heppner, Oregon


SE 1/4 SE 1/4 Sec. 31 T. 2 N. S. R. 27 E. W.M.

Bearing and distance from section or subdivision corner \_\_\_\_\_

Altitude at well \_\_\_\_\_

TYPE OF WELL: drilled Date Constructed 5/27/52

Depth drilled 159 ft. Depth cased 36 ft. 4 in.

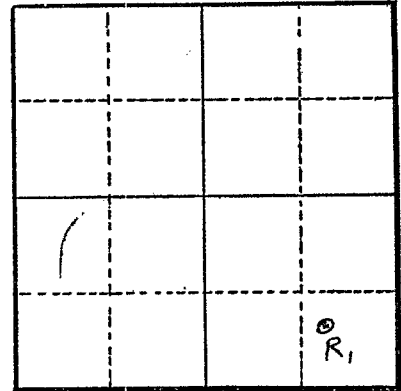

Section 31

CASING RECORD: 10 inch steel casing set from 0 to 36 ft. 4 inches

FINISH: \_\_\_\_\_

AQUIFERS: Basalt porous zones between 104 to 133  
133 to 141  
146 to 159

WATER LEVEL: 25 ft. below land surface (rpt. 8/5/52)

PUMPING EQUIPMENT: Type Peerless turbine 6 inch H.P. 20  
Capacity 350 G.P.M.

WELL TESTS:  
Drawdown 100 ft. after \_\_\_\_\_ hours pumping 238 G.P.M.  
Drawdown 129 ft. after \_\_\_\_\_ hours pumping 350 G.P.M.

USE OF WATER municipal Temp. \_\_\_\_\_ °F., 19  
SOURCE OF INFORMATION Victor Groshens - City Superintendent  
DRILLER or DIGGER A. A. Durand

ADDITIONAL DATA:  
Log  Water Level Measurements \_\_\_\_\_ Chemical Analysis \_\_\_\_\_ Aquifer Test \_\_\_\_\_

REMARKS: \_\_\_\_\_

