

STATE ENGINEER
Salem, Oregon

WORK 202

Well Record

STATE WELL NO. 2/28-12E(1)
COUNTY Morrow
APPLICATION NO. _____

OWNER: W. E. Hughes MAILING ADDRESS: _____

LOCATION OF WELL: Owner's No. _____ CITY AND STATE: _____


SW $\frac{1}{4}$ NW $\frac{1}{4}$ Sec. 12 T. 2 ^N S., R. 28 ^{E.} ~~W.~~, W.M.

Bearing and distance from section or subdivision corner _____

Altitude at well _____

TYPE OF WELL: drilled Date Constructed _____

Depth drilled 150 Depth cased _____

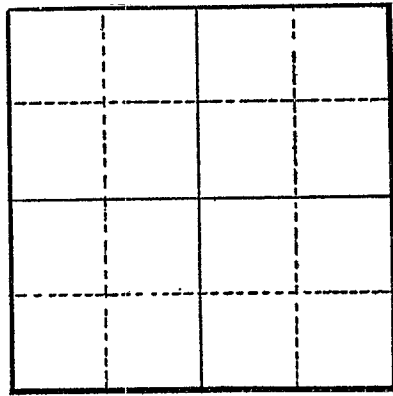

Section _____

CASING RECORD: 8 inch

FINISH: _____

AQUIFERS: basalt

WATER LEVEL: 23.85

PUMPING EQUIPMENT: Type turbine H.P. _____
Capacity _____ G.P.M.

WELL TESTS:
Drawdown _____ ft. after _____ hours _____ G.P.M.
Drawdown _____ ft. after _____ hours _____ G.P.M.

USE OF WATER domestic, stock Temp. _____ °F. _____, 19_____

SOURCE OF INFORMATION _____
DRILLER or DIGGER _____

ADDITIONAL DATA:
Log _____ Water Level Measurements X Chemical Analysis _____ Aquifer Test _____

REMARKS:
See plate 15 for water-level record.