

STATE ENGINEER
Salem, Oregon

MORR 317


Well Record

STATE WELL NO. 3/28-29J
COUNTY Morrow
APPLICATION NO. GR-3052

OWNER: Victor Groshens
City Superintendent
LOCATION OF WELL: Owner's No. 2
MAILING ADDRESS: City of Heppner
CITY AND STATE: Heppner, Oregon

NE 1/4 SE 1/4 Sec. 29 T. 3 N. S. R. 28 E. W., W.M.

Bearing and distance from section or subdivision
corner 2030 feet North and 190 feet West of the SE
Corner, Section 29.

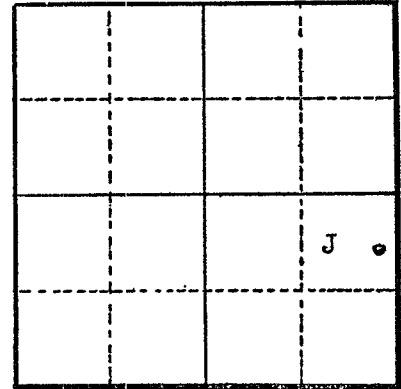

Section 29

Altitude at well 2870 feet

TYPE OF WELL: Drilled Date Constructed 1932

Depth drilled 352 feet Depth cased 28 feet

CASING RECORD:

10-inch casing set from 0 to 28 feet

FINISH:

AQUIFERS:

sandstone, rock

WATER LEVEL:

90 feet

PUMPING EQUIPMENT: Type 6" Peerless Turbine H.P.

Capacity 500 G.P.M.

WELL TESTS:

Drawdown 1 ft. after 3 hours G.P.M.

Drawdown 114 ft. after 350 hours G.P.M.

USE OF WATER Municipal Temp. °F., 19

SOURCE OF INFORMATION GR-4033

DRILLER or DIGGER R. G. Strasser, Portland, Oregon

ADDITIONAL DATA:

Log Water Level Measurements Chemical Analysis Aquifer Test

REMARKS:

