

NOTICE TO WATER WELL CONTRACTOR
The original and first copy of this report
are to be filed with the

MORR 35

2S 24 E 2 NENW

WATER RESOURCES DEPARTMENT,
SALEM, OREGON 97310
within 30 days from the date
of well completion.

RECEIVED

WATER WELL REPORT

STATE OF OREGON

(Please type or print)

JAN 22 1979

(Do not write above this line)

State Well No.

State Permit No.

WATER RESOURCES DEPT.

(1) OWNER: SALEM, OREGON

Name ROD MURRAY
Address HEPPNER OR

(2) TYPE OF WORK (check):

New Well ☒ Deepening ☐ Reconditioning ☐ Abandon ☐

If abandonment, describe material and procedure in Item 12.

(3) TYPE OF WELL:

Rotary ☒ Driven ☐
Cable ☐ Jetted ☐
Dug ☐ Bored ☐

(4) PROPOSED USE (check):

Domestic ☒ Industrial ☐ Municipal ☐
Irrigation ☒ Test Well ☐ Other ☐

(5) CASING INSTALLED:

8" Diam. from +2 ft. to -18 ft. Gage 250
" Diam. from ft. to ft. Gage
" Diam. from ft. to ft. Gage

(6) PERFORATIONS:

Perforated? ☐ Yes ☒ No.

Type of perforator used

Size of perforations in. by in.
perforations from ft. to ft.
perforations from ft. to ft.
perforations from ft. to ft.

(7) SCREENS:

Well screen installed? ☐ Yes ☒ No

Manufacturer's Name
Type Model No.
Diam. Slot size Set from ft. to ft.
Diam. Slot size Set from ft. to ft.

(8) WELL TESTS:

Drawdown is amount water level is
lowered below static level

Was a pump test made? ☒ Yes ☐ No If yes, by whom? DRILLER

d: 450 gal./min. with ft. drawdown after hrs.

" " " "

Bailer test gal./min. with ft. drawdown after hrs.

Artesian flow g.p.m.

Temperature of water 63 Depth artesian flow encountered ft.

(9) CONSTRUCTION:

Well seal—Material used PORTLAND CEMENT

Well sealed from land surface to 18 ft.

Diameter of well bore to bottom of seal 12 in.

Diameter of well bore below seal 8 in.

Number of sacks of cement used in well seal 9 sacks

How was cement grout placed? Pressure grouted

from bottom to the top with
out interruption

Was a drive shoe used? ☐ Yes ☒ No Plugs Size: location ft.

Did any strata contain unusable water? ☐ Yes ☒ No

Type of water? depth of strata

Method of sealing strata off

Was well gravel packed? ☐ Yes ☒ No Size of gravel:

Gravel placed from ft. to ft.

(10) LOCATION OF WELL:

County MORROW Driller's well number

SW 1/4 SE 1/4 Section 35 T. 15 R. 24 E W.M.

Bearing and distance from section or subdivision corner

(11) WATER LEVEL: Completed well.

Depth at which water was first found 170 ft.

Static level 6 ft. below land surface. Date 12-18-78

Artesian pressure lbs. per square inch. Date

(12) WELL LOG:

Diameter of well below casing 7 7/8

Depth drilled 440 ft. Depth of completed well 440 ft.

Formation: Describe color, texture, grain size and structure of materials;
and show thickness and nature of each stratum and aquifer penetrated,
with at least one entry for each change of formation. Report each change in
position of Static Water Level and indicate principal water-bearing strata.

MATERIAL	From	To	SWL
Soil	0	6	
GRAVEL	6	12	
BASALT Black	12	170	
" Black & Red	170	225	906
" Black	225	382	
" Black w/GR clay	382	410	1756
" Black	410	418	
" Red	418	438	4506
" Black	438	440	

Work started 12-16 1978 Completed 12-19 1978

Date well drilling machine moved off of well 12-20 1978

Drilling Machine Operator's Certification:

This well was constructed under my direct supervision.
Materials used and information reported above are true to my
best knowledge and belief.

[Signed] Marvin Fitchfield Date 12-20, 1978
(Drilling Machine Operator)

Drilling Machine Operator's License No. 1299

Water Well Contractor's Certification:

This well was drilled under my jurisdiction and this report is
true to the best of my knowledge and belief.

Name Tony Burd Well Drilling
(Person, firm or corporation) (Type or print)

Address Pendleton OR

[Signed] Tony Burd
(Water Well Contractor)

Contractor's License No. 544 Date 12-20 1978



Oregon Water Resources Department
725 Summer Street NE, Suite A
Salem Oregon 97301
(503) 986-0900
www.wrd.state.or.us

Application for Well ID Number

RECEIVED BY OWRD

Do not complete if the well already has a Well Identification Number.

FEB 11 2016

SALEM, OR

I. OWNER INFORMATION

Current Owner Name (please print): Rod Murray

Mailing Address: 64132 Rhea Creek Road

City, State, Zip: lone, OR 97843

Mail Well ID Tag to: ☒ SAME AS ABOVE ☐ In Care Of (C/O)

Name & Address: _____

City, State, Zip: _____

II. WELL LOCATION INFORMATION (Please fill out as completely as possible)

Township: 2 (~~North~~ / South) Range: 24 (East / ~~West~~) Section: 2

Tax Lot: 502 County: Morrow NE 1/4 NW 1/4

GPS Coordinates: _____

Street Address of Well, City: 64132 Rhea Creek Road, lone, OR 97843

If the property had a different street address in the past: _____

III. GENERAL WELL INFORMATION (Please fill out as completely as possible)

Use of Well (domestic, irrigation, commercial, industrial, monitoring): Irrigation and domestic

Date Well Constructed (or property built): _____ Total Well Depth: _____ Casing Diameter: _____

Owner at time the well was constructed (if known): _____

Other Information: See MORR 35 (copy attached)

SUBMITTED BY (please print): John R. Murray

97836-0427

PHONE: 541-980-8880

EMAIL &/or FAX: jrmurraydro@gmail.com

Send application to: Oregon Water Resources Department 725 Summer St NE, Suite A, Salem, Oregon 97301; or fax to (503) 986-0902. Applications are processed in the order they are received, and Well ID Numbers are mailed within 4-5 business days.

For Official Use Only by the Oregon Water Resources Department:

Received Date:

2-11-16

Well Log Number:

MORR 35

Well Identification #:

L-121707


MORR 35

G-17174

RX Ranch

T 1S R 24E Section 35 Tax Lot 4100, 4101, & 4102

T 2S R 24E Section 2 Tax Lot 500, 501, & 502

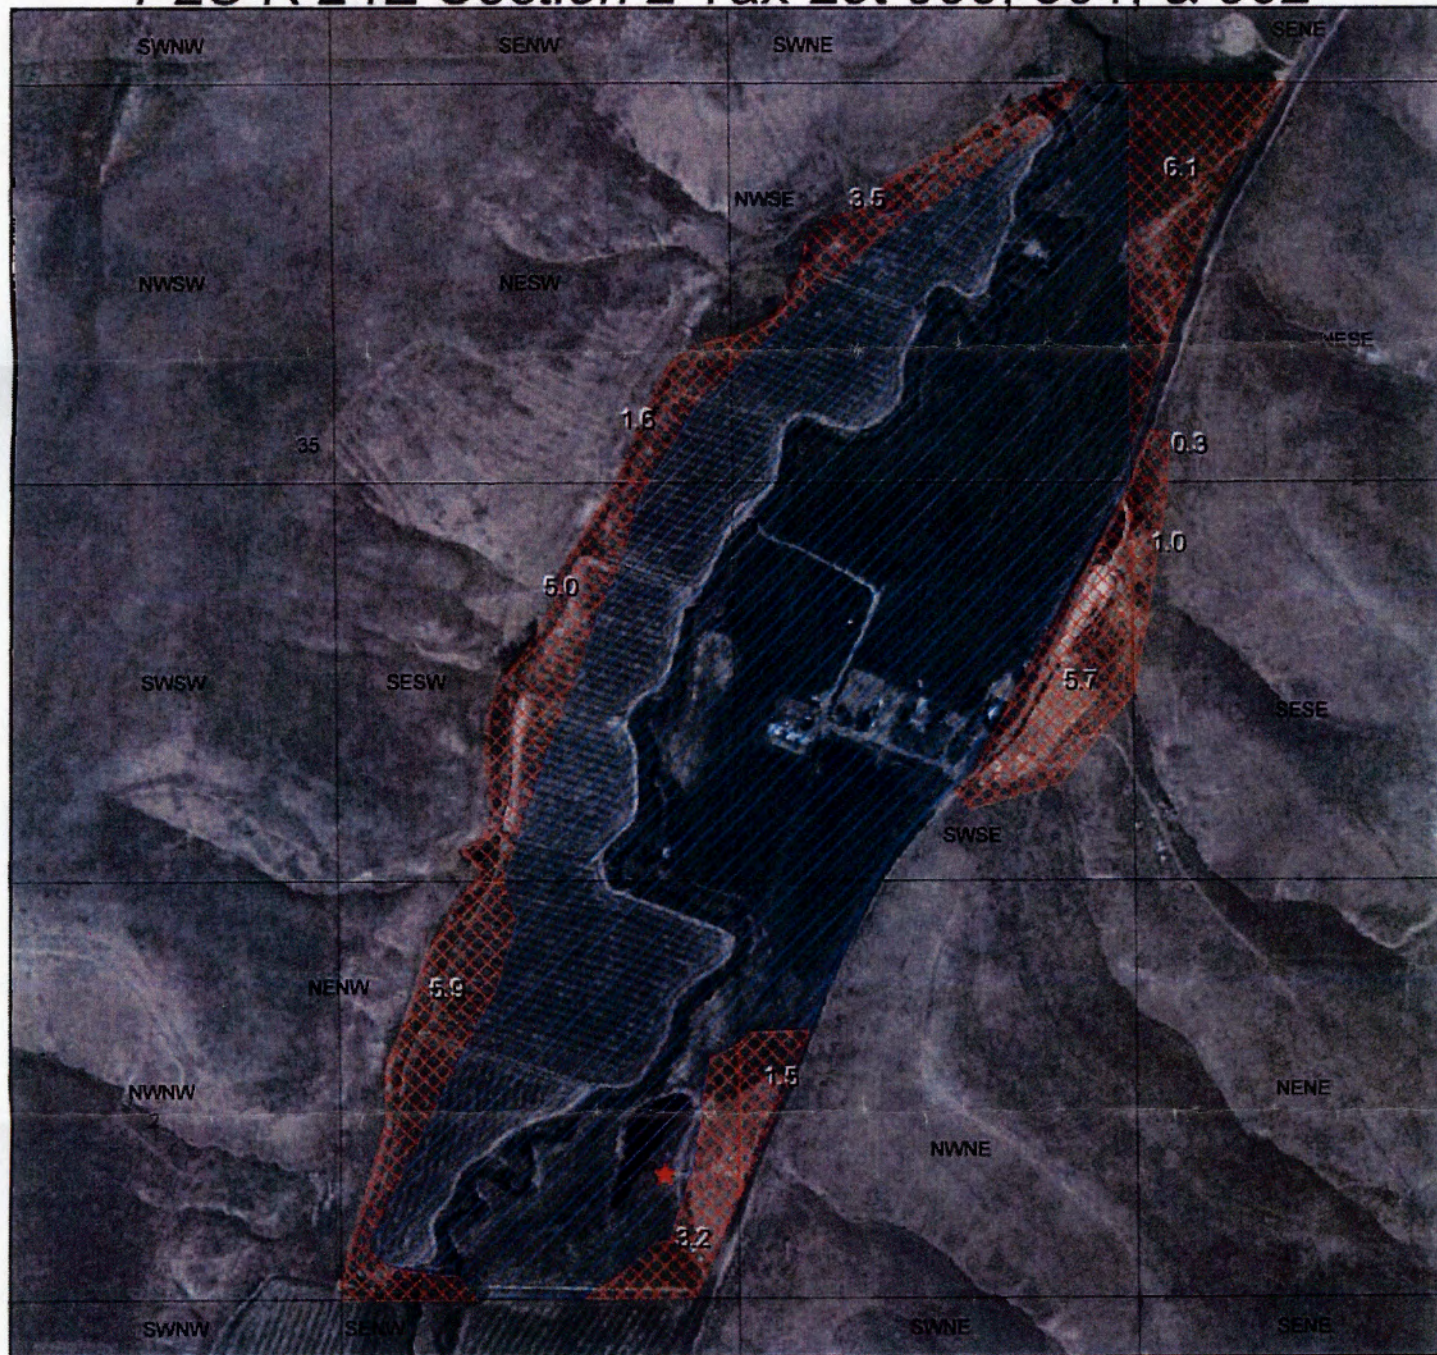

0 550 1,100 2,200 Feet

1 inch equals 600 feet

★ = well MORR 35: 820 feet South and 2320 feet East from the NW corner of section 2

▨ = Primary irrigation application

▨ = supplemental irrigation under Permit G-15220

RECEIVED

FEB 06 2009

WATER RESOURCES DEPT
SALEM, OREGON



RECEIVED BY OWRD

FEB 11 2016

SALEM, OR

--OWRD GIS jtc, WMdistrict21: RXRanch_080814.mxd

This product is for informational purposes and may not have been prepared for, or be suitable for legal, engineering, or surveying purposes. Users of this information should review or consult the primary data and information sources to ascertain the usability of the information.

17