

STATE ENGINEER
Salem, Oregon

OBSERVATION WELL
Well Record

STATE WELL NO. ^{10A} 1N/27-~~11~~(1)
COUNTY Morrow
APPLICATION NO. U-540
adc

~~MORR 466~~
MORR 466

OWNER: Earl Wattenburger


MAILING ADDRESS:

LOCATION OF WELL: Owner's No.

CITY AND STATE:

SE 1/4 SE 1/4 Sec. 3 T. 1 N. S., R. 27 E. W.M.

Bearing and distance from section or subdivision corner

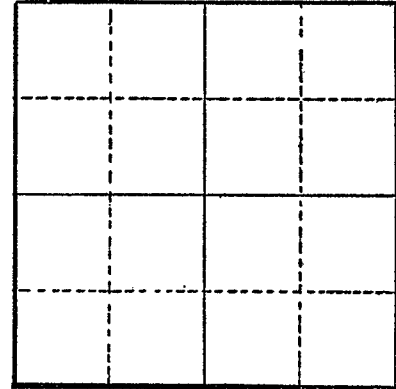

Section

Altitude at well 1040

TYPE OF WELL: Dr. Date Constructed 1952

Depth drilled 120 SEE DEEPENING 2-25-67 Depth cased

CASING RECORD: 8 inch

FINISH:

AQUIFERS: Basalt

WATER LEVEL: 9.0' 1-25-61
2.0' 5-24-61
0.5' 11-7-61

PUMPING EQUIPMENT: Type turbine H.P.
Capacity 235 G.P.M.

WELL TESTS:
Drawdown 55 ft. after 1 hours 200 G.P.M.
Drawdown ft. after hours G.P.M.

USE OF WATER irrigation Temp. °F., 19

SOURCE OF INFORMATION USGS

DRILLER or DIGGER Ben Dreyer

ADDITIONAL DATA:

Log Water Level Measurements Chemical Analysis Aquifer Test

REMARKS:

