

STATE ENGINEER
Salem, Oregon

*MARK (4)
957*

Well Record


STATE WELL NO. 4N/27-28G(1)
COUNTY Morrow
APPLICATION NO. G-139 U-545

OWNER: S. F. Hoyt (Braat) MAILING ADDRESS: Commadore Apts.

LOCATION OF WELL: Owner's No. _____ CITY AND STATE: The Dalles, Oregon

SW $\frac{1}{4}$ NE $\frac{1}{4}$ Sec. 28 T. 4 N. S., R. 27 W., W.M.

Bearing and distance from section or subdivision
corner 1470 ft. W. & 3300' N. from SE cor. Sec. 28

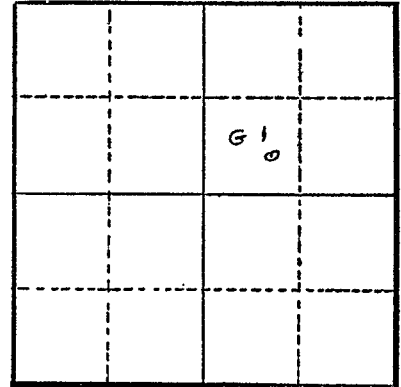

Section 28

Altitude at well _____

TYPE OF WELL: drilled Date Constructed 1954

Depth drilled 126 Depth cased 126

CASING RECORD: 12 inch

FINISH:

AQUIFERS: gravel

WATER LEVEL:

72.00' (11-10-61)

PUMPING EQUIPMENT: Type turbine H.P. _____
Capacity 1250 G.P.M.

WELL TESTS:

Drawdown _____ ft. after _____ hours _____ G.P.M.

Drawdown _____ ft. after _____ hours _____ G.P.M.

USE OF WATER irrigation Temp. _____ °F., 19_____

SOURCE OF INFORMATION USGS

DRILLER or DIGGER A. M. Edwards

ADDITIONAL DATA:

Log Water Level Measurements _____ Chemical Analysis _____ Aquifer Test _____

REMARKS:

