

STATE ENGINEER
Salem, Oregon

MORR
975

516

Well Record

STATE WELL NO. 4N/27-32G(1)
COUNTY Morrow
APPLICATION NO. U-572, U-573
U-856

OWNER: Georgia Bell & Ray Gail Halzapfel MAILING ADDRESS: Box 315

LOCATION OF WELL: Owner's No. _____ CITY AND STATE: Wasco, Oregon

SW 1/4 NE 1/4 Sec. 32 T. 4 N. S, R. 27 E. W, W.M.


Bearing and distance from section or subdivision corner _____

Altitude at well _____

TYPE OF WELL: drilled Date Constructed Jan. 1954

Depth drilled 123 Depth cased _____

CASING RECORD: 12 inch

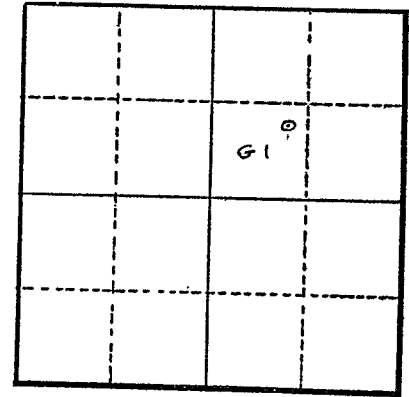

FINISH: _____

AQUIFERS: gravel

WATER LEVEL: 77' below LSD, January, 1954
73.54' " " 11-10-61

PUMPING EQUIPMENT: Type turbine (Worthington) H.P. 40
Capacity 450 G.P.M.

WELL TESTS:
Drawdown _____ ft. after _____ hours _____ G.P.M.
Drawdown _____ ft. after _____ hours _____ G.P.M.

USE OF WATER irrigation Temp. _____ °F. _____, 19____

SOURCE OF INFORMATION _____

DRILLER or DIGGER _____

ADDITIONAL DATA:
Log Water Level Measurements _____ Chemical Analysis _____ Aquifer Test _____

REMARKS: _____

