

STATE ENGINEER
Salem, Oregon

*MORE
ONE*

OBSERVATION WELL
Well Record


STATE WELL NO. ^J4N/27-32(1)
COUNTY Morrow
APPLICATION NO. U-572, U-573,
U-859

OWNER: Georgia Belle & Roy Gail Holsapfel MAILING ADDRESS: Box 315

LOCATION OF WELL: Owner's No. 2 CITY AND STATE: Wasco, Oregon

SE $\frac{1}{4}$ SE $\frac{1}{4}$ Sec. 32 T. 4 N. S. R. 27 E. W.M.

Bearing and distance from section or subdivision corner Well is shown on map as being at the intersection of the quarter-quarter section lines in the SE $\frac{1}{4}$ of Section 32

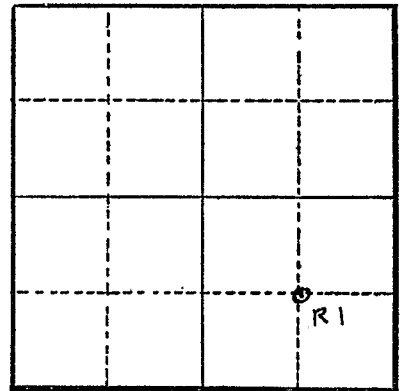

Altitude at well _____

TYPE OF WELL: drilled Date Constructed Oct. Nov. 53

Depth drilled 310 Depth cased _____

Section 32

CASING RECORD: 12 inch

*Well abandoned
does not exist
any longer*

FINISH:

AQUIFERS: Basalt, 295 to 310 ft.

WATER LEVEL: 90 ft. below LSD in 1953
75.99' " " 11-10-61

PUMPING EQUIPMENT: Type turbine (Worthington) H.P. 50
Capacity 350 G.P.M.

WELL TESTS:
Drawdown _____ ft. after _____ hours _____ G.P.M.
Drawdown _____ ft. after _____ hours _____ G.P.M.

USE OF WATER Irrigation Temp. _____ °F., 19_____

SOURCE OF INFORMATION U-573

DRILLER or DIGGER H. T. Leonard

ADDITIONAL DATA:
Log Water Level Measurements Chemical Analysis _____ Aquifer Test _____

REMARKS: THIS WELL CANCELED FROM CRT.

