

STATE ENGINEER  
Salem, Oregon

# Well Record

STATE WELL NO. 4N/27-33M(1)  
COUNTY Morrow  
APPLICATION NO. \_\_\_\_\_

OWNER: E.F. McDole


MAILING ADDRESS: \_\_\_\_\_

LOCATION OF WELL: Owner's No. 3

CITY AND STATE: \_\_\_\_\_

NW  $\frac{1}{4}$  SW  $\frac{1}{4}$  Sec. 33 T. 4 N. S, R. 27 E. W., W.M.

Bearing and distance from section or subdivision corner \_\_\_\_\_

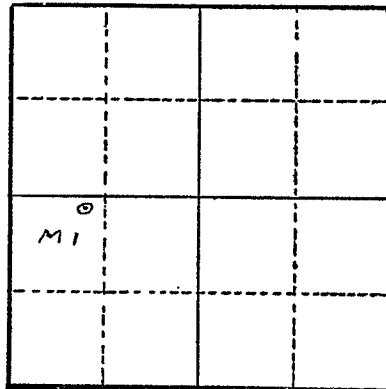

Section 33

Altitude at well \_\_\_\_\_

TYPE OF WELL: Dr. Date Constructed 1956

Depth drilled 111 Depth cased 83

CASING RECORD: 12 inch

FINISH: \_\_\_\_\_

AQUIFERS: \_\_\_\_\_

WATER LEVEL: 6 ft. ?  
71.99' (11-8-61)

PUMPING EQUIPMENT: Type turbine H.P. 40  
Capacity \_\_\_\_\_ G.P.M.

WELL TESTS:  
Drawdown \_\_\_\_\_ ft. after \_\_\_\_\_ hours \_\_\_\_\_ G.P.M.  
Drawdown \_\_\_\_\_ ft. after \_\_\_\_\_ hours \_\_\_\_\_ G.P.M.

USE OF WATER \_\_\_\_\_ Temp. \_\_\_\_\_ °F. \_\_\_\_\_, 19\_\_\_\_\_

SOURCE OF INFORMATION \_\_\_\_\_

DRILLER or DIGGER \_\_\_\_\_

ADDITIONAL DATA:

Log N.A. Water Level Measurements X Chemical Analysis \_\_\_\_\_ Aquifer Test \_\_\_\_\_

REMARKS: \_\_\_\_\_