

STATE ENGINEER #1
Salem, Oregon

OBSERVATION WELL
Well Record

STATE WELL NO. 4N/27-33H(1)
COUNTY Morrow
APPLICATION NO.


MOORE
987

OWNER: M M McDole
McDole Bros.

MAILING ADDRESS:
CITY AND STATE:

LOCATION OF WELL: Owner's No. 1
SE 1/4 NE 1/4 Sec. 33 T. 4 N. R. 27 E. W.M.

Bearing and distance from section or subdivision corner

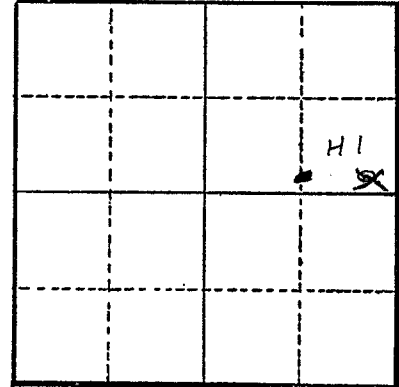

Section 33

Altitude at well 560 ft.

TYPE OF WELL: Dr. Date Constructed 1950
Depth drilled 96 ft. Depth cased 96 ft.

CASING RECORD: 12 inch

FINISH:

AQUIFERS: unconfined

WATER LEVEL: 63 ft. 64.52 12/1/54
69.76' 11-8-61

PUMPING EQUIPMENT: Type H.P.
Capacity G.P.M.

WELL TESTS:
Drawdown ft. after hours G.P.M.
Drawdown ft. after hours G.P.M.

USE OF WATER irrigation Temp. 62 °F., 19.50

SOURCE OF INFORMATION USGS

DRILLER or DIGGER L. E. Wallis

ADDITIONAL DATA:

Log X Water Level Measurements X Chemical Analysis Aquifer Test

REMARKS:

