

STATE ENGINEER  
Salem, Oregon

MULT  
1005

# Well Record

STATE WELL NO. 1N/1-25J  
COUNTY Multnomah  
APPLICATION NO. GR-3606

OWNER: Hollywood Branch of U. S. National Bank of Portland


MAILING ADDRESS: 1901 N.E. 42nd Avenue

LOCATION OF WELL: Owner's No.

CITY AND STATE: Portland, Oregon

NE 1/4 SE 1/4 Sec. 25 T. 1 N. 8, R. 1 E. W., W.M.

Bearing and distance from section or subdivision corner 80' N. and 45' W.

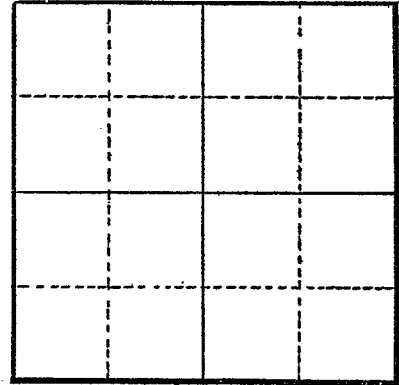

Section

Altitude at well

TYPE OF WELL: drilled Date Constructed 1941

Depth drilled 250' Depth cased 250'

### CASING RECORD:

8"

### FINISH:

3/8" x 1 1/4" perforation 20/ft from 155 to 166

### AQUIFERS:

### WATER LEVEL:

125'

PUMPING EQUIPMENT: Type Pomona Direct Drive Turbine H.P. 10  
Capacity G.P.M.

### WELL TESTS:

Drawdown 4 ft. after hours pumping 25 G.P.M.

Drawdown ft. after hours G.P.M.

USE OF WATER Industrial uses Temp. °F., 19

SOURCE OF INFORMATION GR-3154

DRILLER or DIGGER

### ADDITIONAL DATA:

Log Water Level Measurements Chemical Analysis Aquifer Test

### REMARKS:

