

STATE ENGINEER
Salem, Oregon

MULT
1009

Well Record


STATE WELL NO. 1N/1-27C(1)
COUNTY Multnomah
APPLICATION NO. GR-301

OWNER: Alvin K. Kaser MAILING ADDRESS: Route 2, Box 119

LOCATION OF WELL: Owner's No. 1 CITY AND STATE: Troutdale, Oregon

NE 1/4 NW 1/4 Sec. 27 T. 1 N. S. R. 1 E. W., W.M.

Bearing and distance from section or subdivision corner 600' W. and 600' N. of SE cor. of NE 1/4 NW 1/4 of Sec. 27.

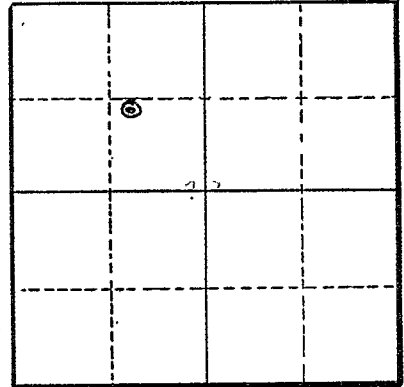

Section 27

Altitude at well 40 feet Interpolated

TYPE OF WELL: Drilled Date Constructed 10-7-52

Depth drilled 238' Depth cased 238'

CASING RECORD:

- 8 inch casing set from 0 to 141 feet
- 5 inch I.D. liner set from 141 to 238 feet

FINISH:

Perforated from 141 to 238 feet

AQUIFERS:

Gravels from 206 to 238 feet

WATER LEVEL:

31 feet below land surface

PUMPING EQUIPMENT: Type Pacific 4" (9 bowls) H.P. 15
Capacity 250 G.P.M.

WELL TESTS:	35	250			
Drawdown	<u>21</u>	ft. after	<u>150</u>	hours	G.P.M.
Drawdown	<u>40</u>	ft. after	<u>300</u>	hours	G.P.M.
	<u>52</u>		<u>400</u>		

USE OF WATER Irrigation 54 acres Temp. 19 °F.

SOURCE OF INFORMATION Registration Statement GR-301

DRILLER or DIGGER

ADDITIONAL DATA:

Log Water Level Measurements Chemical Analysis Aquifer Test

REMARKS:

