

STATE ENGINEER
Salem, Oregon

MULT
1695

Well Record

STATE WELL NO. LN/1-36F
COUNTY MULTNOMAH
~~APPLICATION NO.~~ GR-2807

OWNER: E. S. Cereghino


MAILING ADDRESS: Rt. 2, Box 1166

LOCATION OF WELL: Owner's No. _____

CITY AND STATE: Troutdale, Oregon

SE 1/4 NW 1/4 Sec. 36 T. 1 N. 3 S. R. 3 E. W.M.

Bearing and distance from section or subdivision corner 1550' E. and 1350' S.

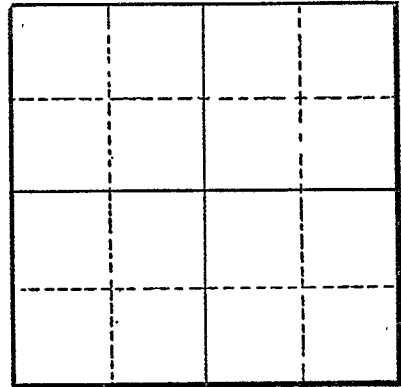

Section _____

Altitude at well _____

TYPE OF WELL: drilled Date Constructed 1945

Depth drilled 82 Depth cased 82

CASING RECORD:

6-inch

FINISH:

AQUIFERS:

WATER LEVEL:

17-feet

PUMPING EQUIPMENT: Type Jacuzzi Jet H.P. 3
Capacity 60 G.P.M.

WELL TESTS:

Drawdown 50 ft. after _____ hours Pumping 60 G.P.M.
Drawdown _____ ft. after _____ hours _____ G.P.M.

USE OF WATER irrigation Temp. _____ °F. _____, 19____

SOURCE OF INFORMATION GR-2649
DRILLER or DIGGER A. M. Jamnsen, 21075 S.W. Tualatin Valley Highway, Aloha, Oregon

ADDITIONAL DATA:

Log _____ Water Level Measurements _____ Chemical Analysis _____ Aquifer Test _____

REMARKS: