

STATE ENGINEER
Salem, Oregon

MULT
1116

Well Record

STATE WELL NO. 1N/2-9 R
COUNTY MULTNOMAH
APPLICATION NO. GR-2946

OWNER: Northwest Packing Co.

MAILING

ADDRESS: P. O. Box 1856


LOCATION OF WELL: Owner's No.

CITY AND

STATE: Portland, Oregon

SE 1/4 SE 1/4 Sec. 9 T. 1 N. S., R. 2 E., W.M.

Bearing and distance from section or subdivision
corner Approx 500' W of the SE Cor of SE 9 & 20'
N of said Section Line

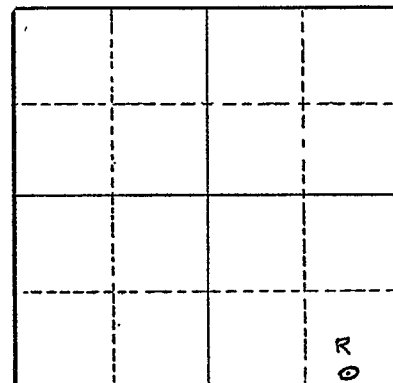

Altitude at well

TYPE OF WELL: Drilled Date Constructed 1949

Depth drilled 190' Depth cased 190'

Section 9

CASING RECORD:

10-inch

FINISH:

3/8" wide & 1 1/4" long spaced 1 1/8" perpendicular
8 rows for 14' in casing total of 40 per Ft (560 perforations)

AQUIFERS:

WATER LEVEL:

16'

PUMPING EQUIPMENT: Type Peerless Deppwell H.P. 40
Capacity 600 G.P.M.

WELL TESTS:

Drawdown 50 ft. after hours 350 G.P.M.
Drawdown 96 ft. after hours 575 G.P.M.

USE OF WATER Irrigation Temp. °F. 19

SOURCE OF INFORMATION GR-3924

DRILLER or DIGGER

ADDITIONAL DATA:

Log ☒ Water Level Measurements ☐ Chemical Analysis ☐ Aquifer Test ☐

REMARKS:

State Well No. 1N/2-9R
County MULTNOMAH
~~Application No.~~ GR-2946

Owner: Northwest Packing Co. Owner's No.

Driller: _____ Date Drilled 1949 _____

[illegible]